


T, 2S., R. 9W., W.M.
SECTION 29

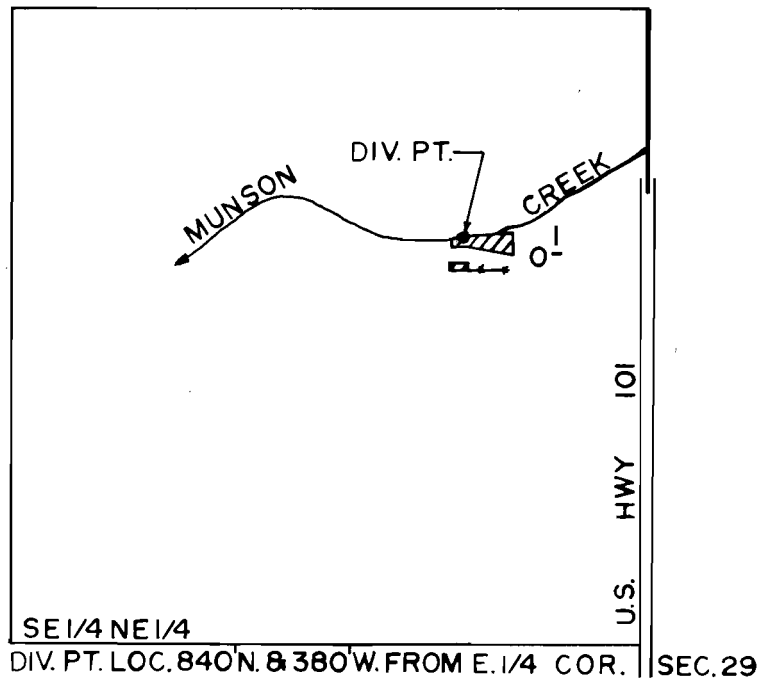

SCALE: 1" = 400'

FINAL PROOF SURVEY
UNDER

Application No. 56208 Permit No. 42096
IN NAME OF

CARL F. HICKS

Surveyed MAY 9 1978, by J.S. DONALDSON