


T.3S. R.2W. W.M.

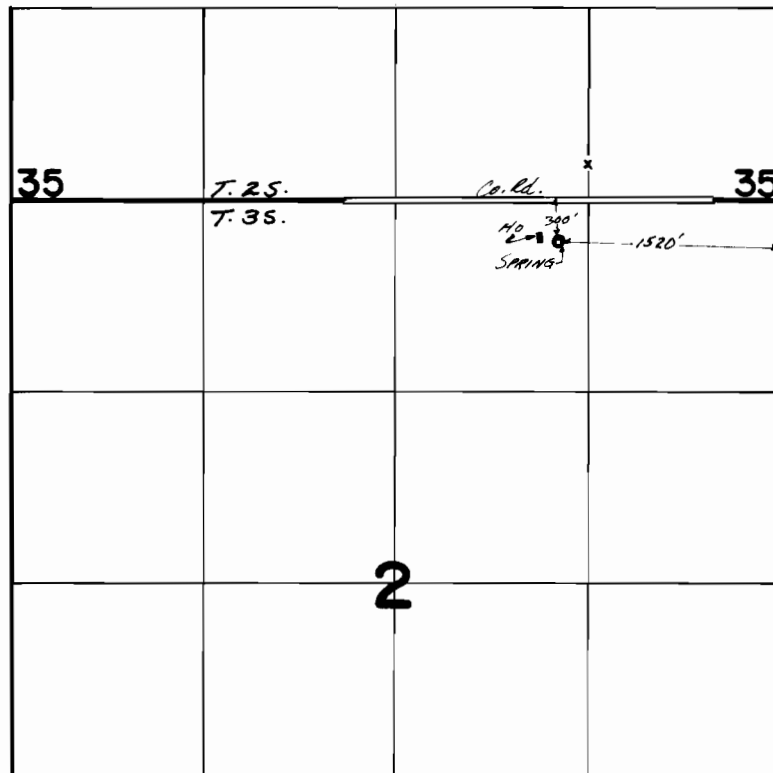

FINAL PROOF SURVEY
UNDER

Application No. 46979 Permit No. 35149
IN NAME OF

LENTHAL E. & MARGARET G. TEDROW

Surveyed July 24 1978, by R.G. Mucken