


T.2S.R.2W.W.M.

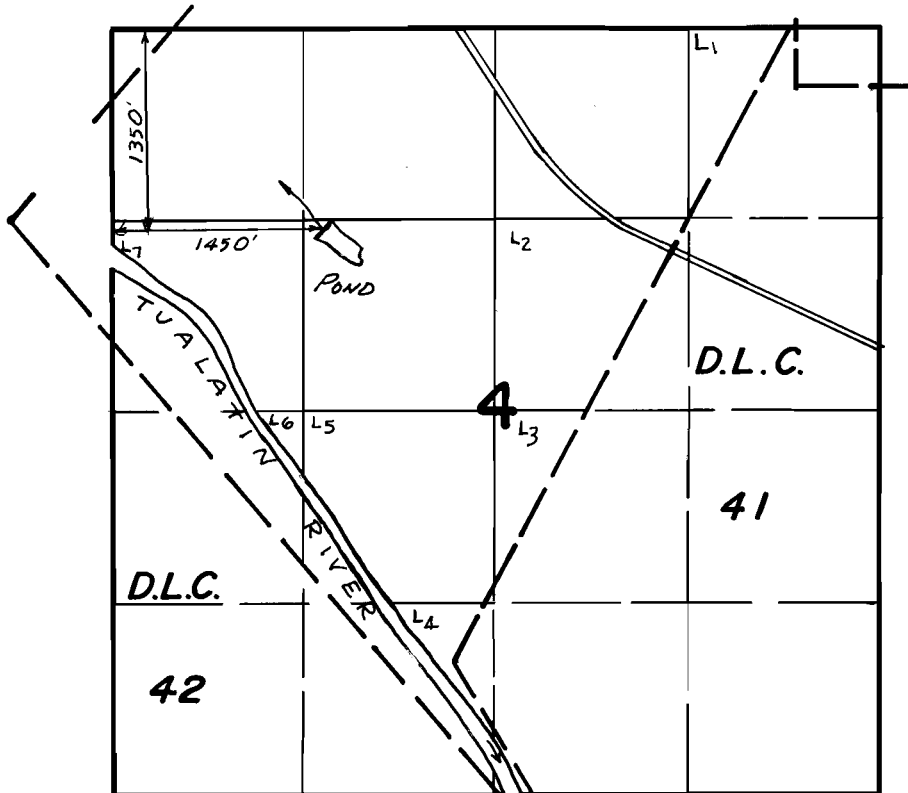

FINAL PROOF SURVEY UNDER

R-52154 R-6258
Application No. 52155 Permit No. 39098
IN NAME OF

HERBERT A. STARK

Surveyed July 26 1978, by R.G. Mucken