

UNITED STATES
DEPARTMENT OF THE INTERIOR
BUREAU OF LAND MANAGEMENT


SECTION

19

Oregon State Water Filings

TOWNSHIP 11 S, RANGE 45 E, W. M.

North

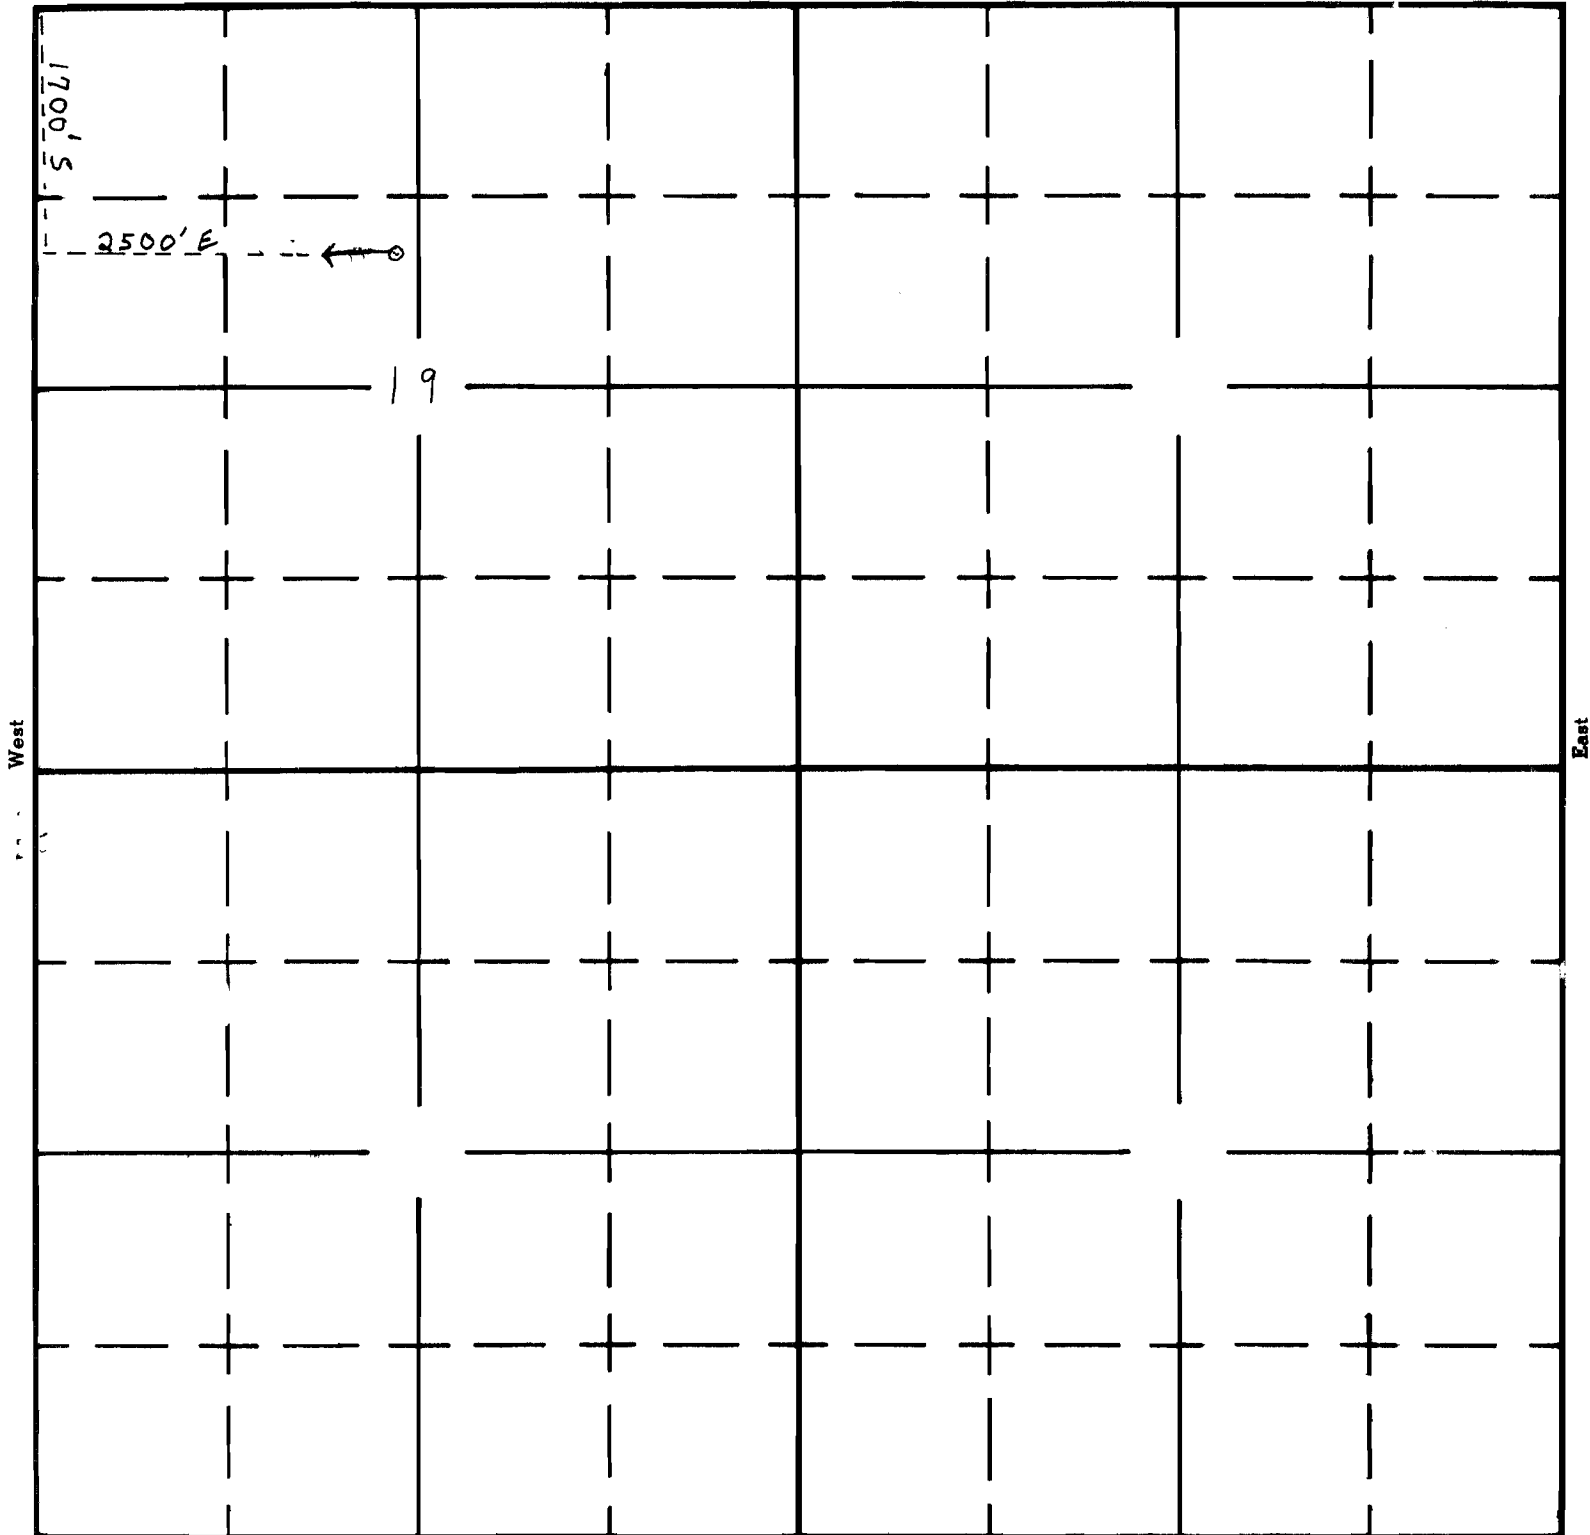

South

APPLICATION No. 38058

PERMIT No. 30201