


T14S. R5W. WM.

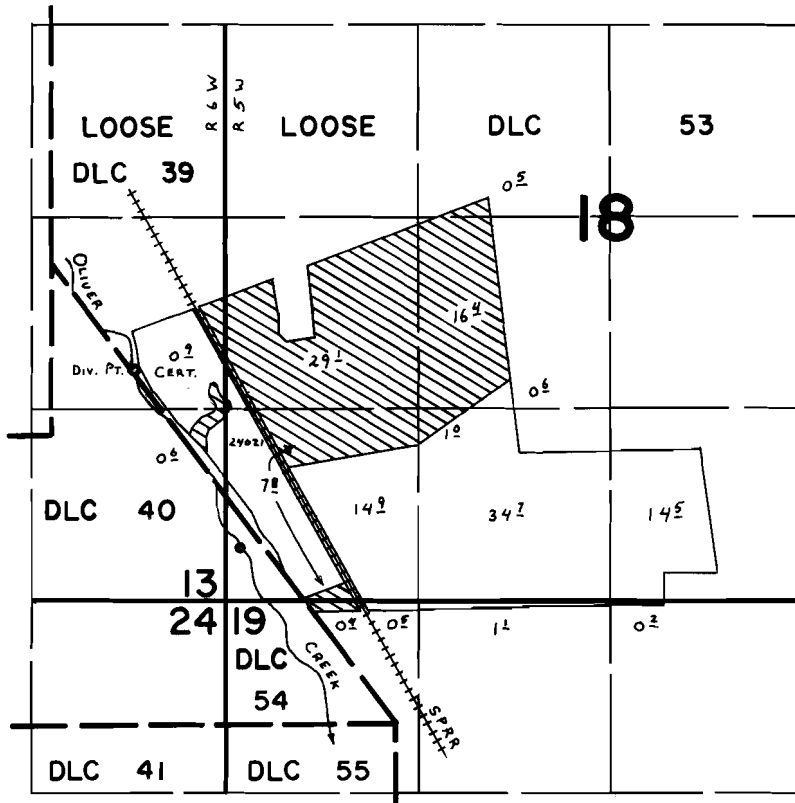

Div. Pt. Loc: 1580' N & 620' W. fr. S.E. Cor. Sec. 13.

FINAL PROOF SURVEY UNDER

Application No. 53147 Permit No. 38778
IN NAME OF

Surveyed Sept. 6, 1979, by C. L. HUGHES