


# T2S. RIE. WM.

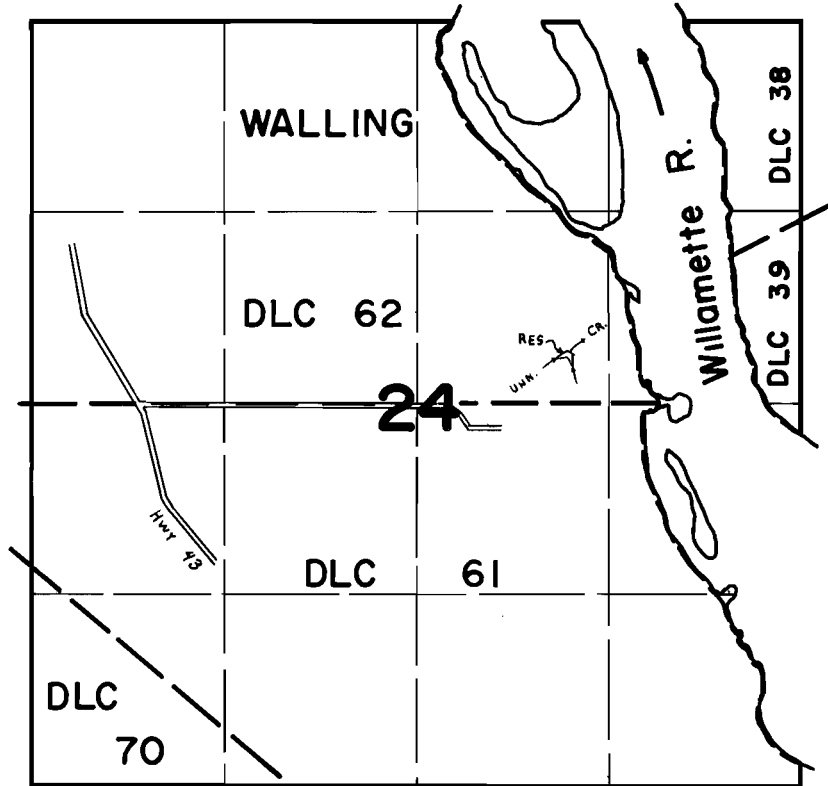

DAM Loc: 2270' S. & 3690' E. fr. NW. Cor. Sec. 24.

## FINAL PROOF SURVEY UNDER

R-50941 R-6032  
Application No. 50942 Permit No. 37141  
IN NAME OF

OREGON STATE HIGHWAY DIVISION  
PARKS & RECREATION BRANCH  
Surveyed OCT. 17, 1978, by C. L. HUGHES...