


Per 2371  
5656

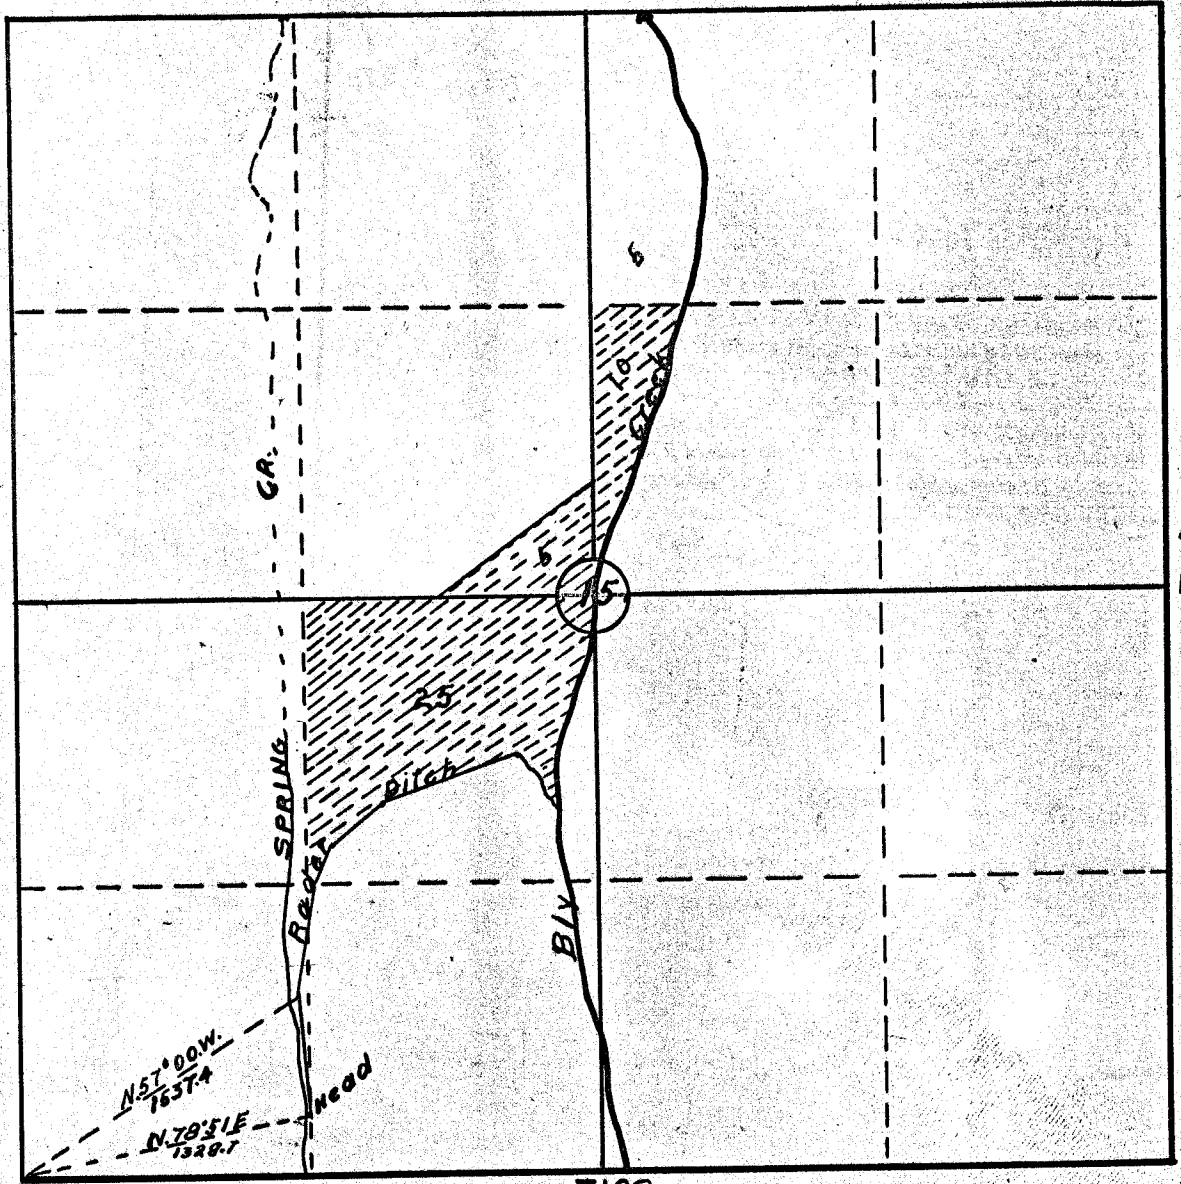

I, Ver  
certi  
taken  
on Se  
the w  
appl  
in the  
on the  
prop  
R30E

T. 109.

App 4093  
Per 2371