


T2S. RIE. WM.

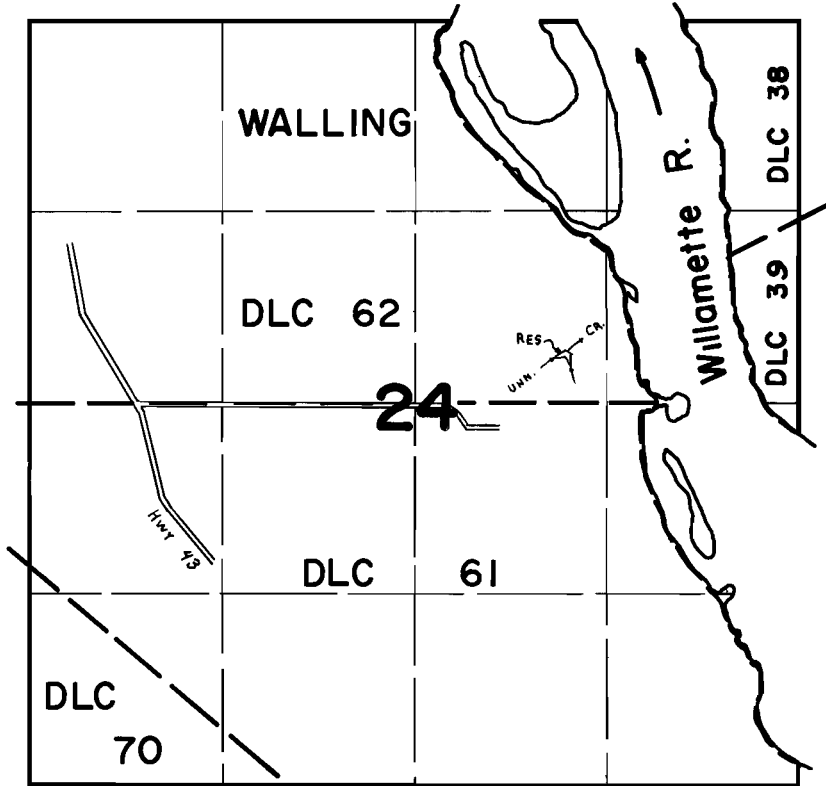

DAM Loc: 2270' S. & 3690' E. fr. NW. Cor. Sec. 24.

FINAL PROOF SURVEY UNDER

Application No. R-50941 50942 Permit No. R-6032 37141
IN NAME OF

OREGON STATE HIGHWAY DIVISION
PARKS & RECREATION BRANCH
Surveyed OCT. 17, 1978, by C. L. HUGHES