


T3S. RIW. WM.

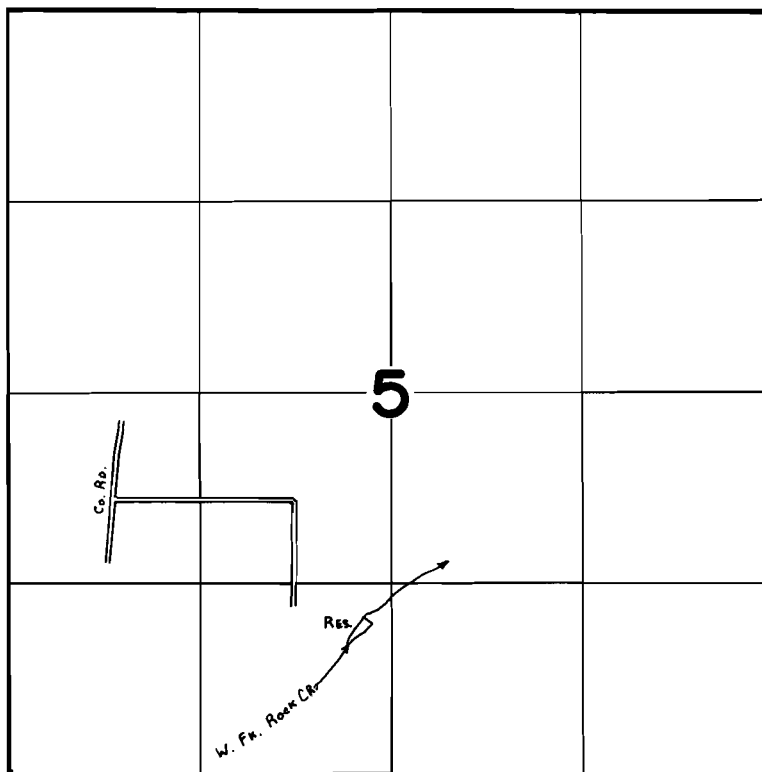

DAM Loc: 1560'S. & 2780'W. fr. E. 1/4 COR. SEC. 5.

FINAL PROOF SURVEY
UNDER

Application No. R-53915 53872 Permit No. R-6440 40394

IN NAME OF

PAUL C. PECK, JR.

Surveyed JUNE 5 1978 by C. L. HUGHES