


•

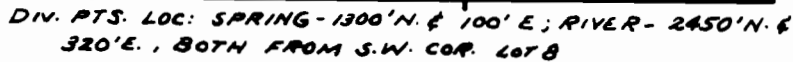

UNDER

IN NAME OF

Oren T. Seal

Surveyed MAR 20 1980., by ROBERT MUCKEN