


# T3S. RIW. WM.

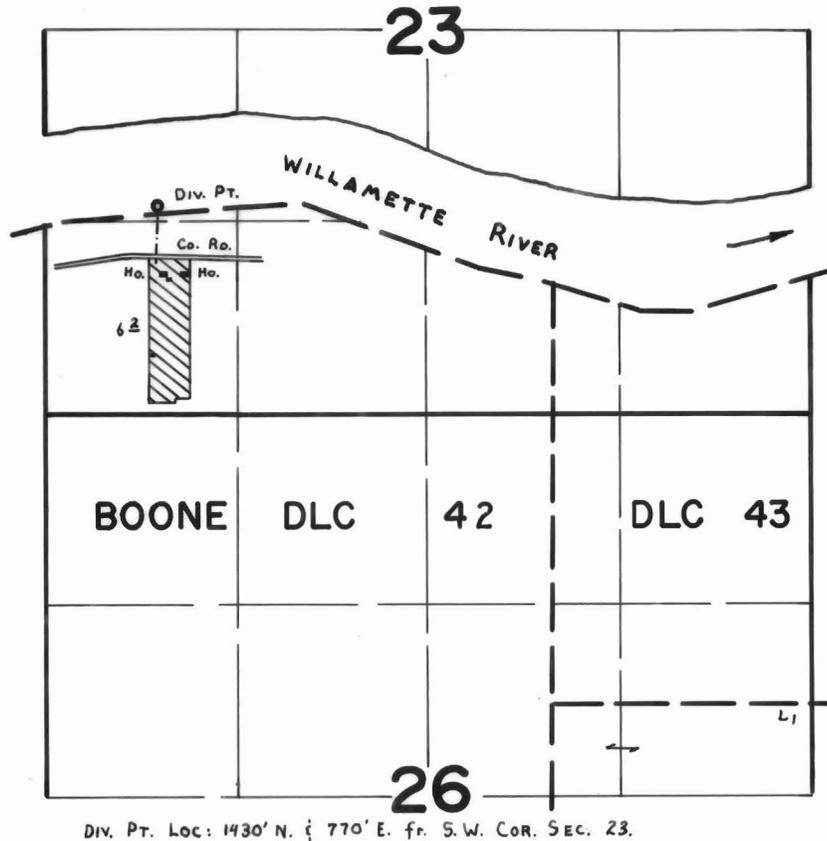

## FINAL PROOF SURVEY UNDER

Application No. 47264 Permit No. 35399

IN NAME OF

FLOYD W. RILEY

Surveyed OCT. 5 1978, by C. L. HUGHES