


T5S. R2E. WM.

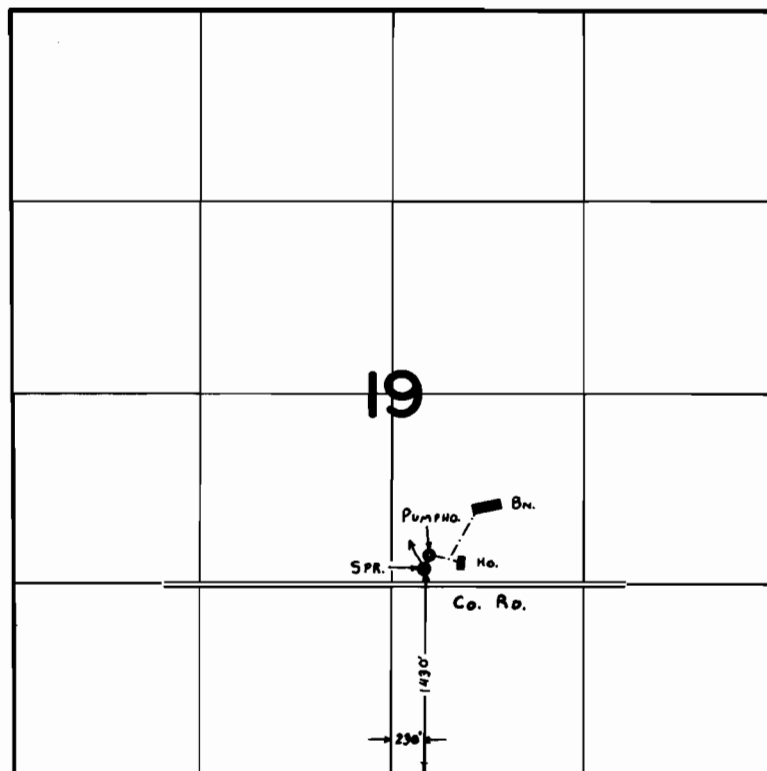

FINAL PROOF SURVEY
UNDER

Application No. 49155 Permit No. 36855
IN NAME OF

LARRY WROLSTAD

Surveyed SEPT. 26 1978, by C. L. HUGHES