


T4S. RIE. WM.

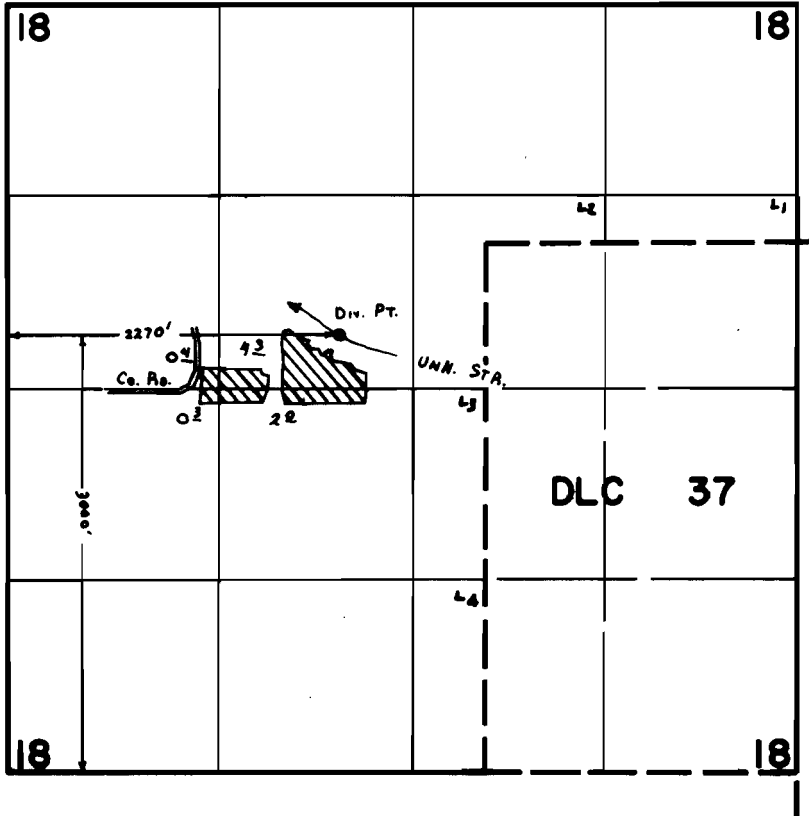

FINAL PROOF SURVEY UNDER

Application No. 53916 Permit No. 40227
IN NAME OF

E. ALLEN GEORGE

Surveyed OCT. 5 1978, by C. L. HUGHES