


T2S. R3E. WM.

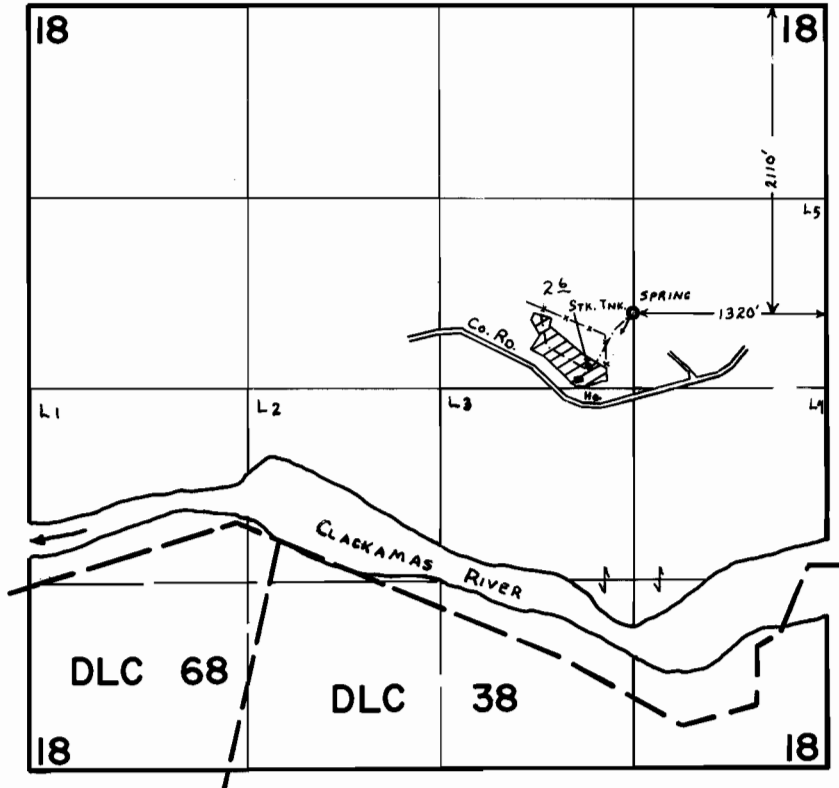

FINAL PROOF SURVEY
UNDER

Application No. 54177 Permit No. 40559
IN NAME OF

AUGUST W. & EDITH D. ENGELKING

Surveyed OCT. 2 1978, by C. L. HUGHES.