


T. 2 S. R. 1 E. W. M.

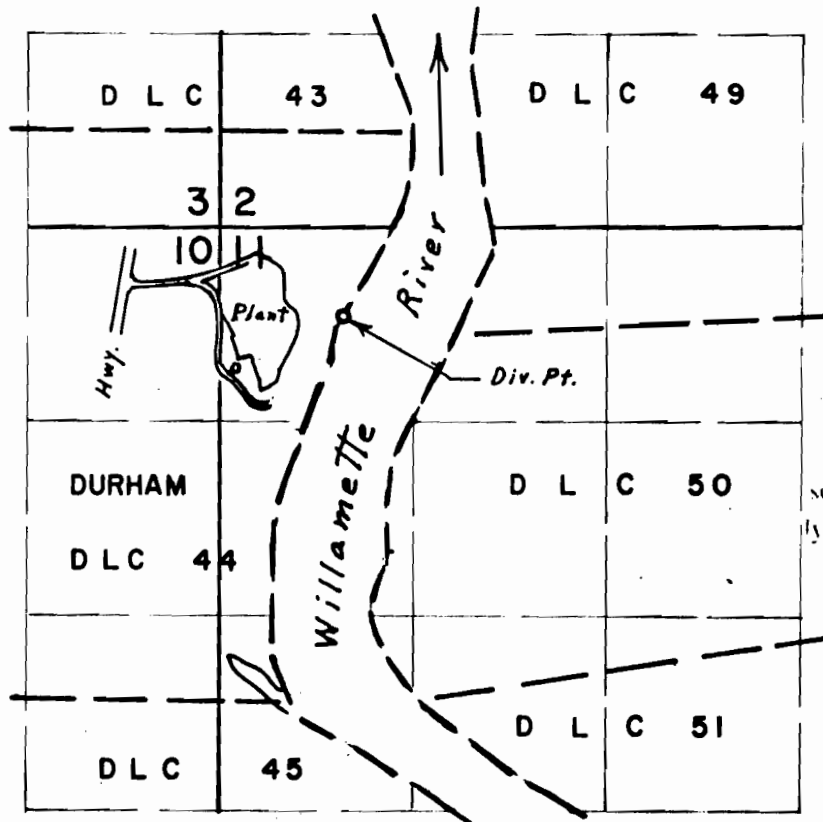

**Application No.** 52852  
**Permit No.** 40597

**FINAL PROOF SURVEY**  
UNDER

Application No. 42168 Permit No. 31556  
IN NAME OF

**OREGON PORTLAND CEMENT COMPANY**

Surveyed Sept. 14, 1972, by L. E. Gould.