


# T3S. R1E. WM.

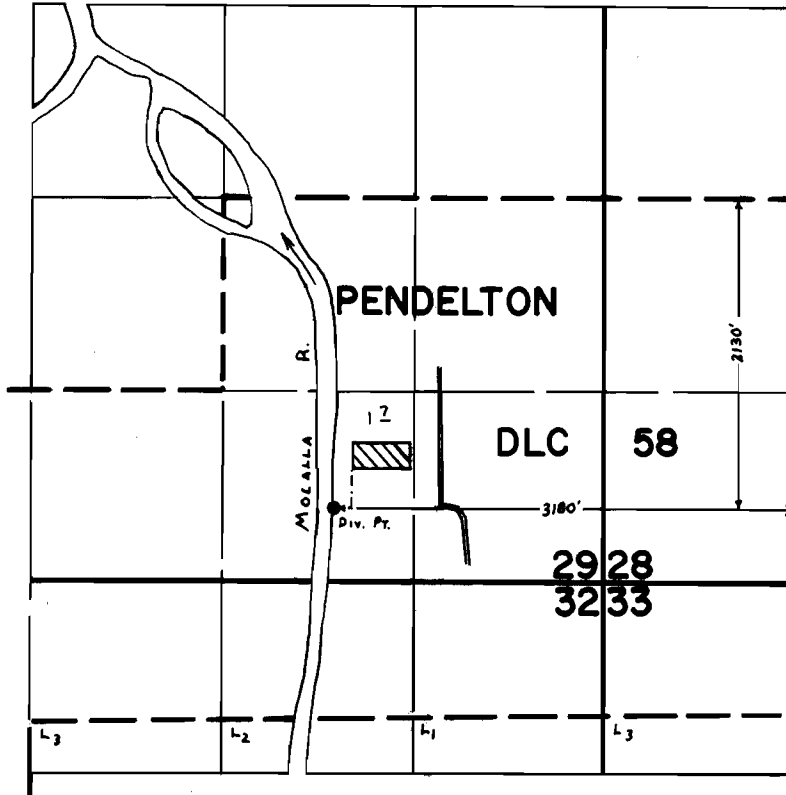

## FINAL PROOF SURVEY UNDER

Application No. 56181 Permit No. 42241

IN NAME OF

JOHN P. BERGHUIS

Surveyed JUNE 6, 1978, by C. L. HUGHES