


T4S. R3E. WM.

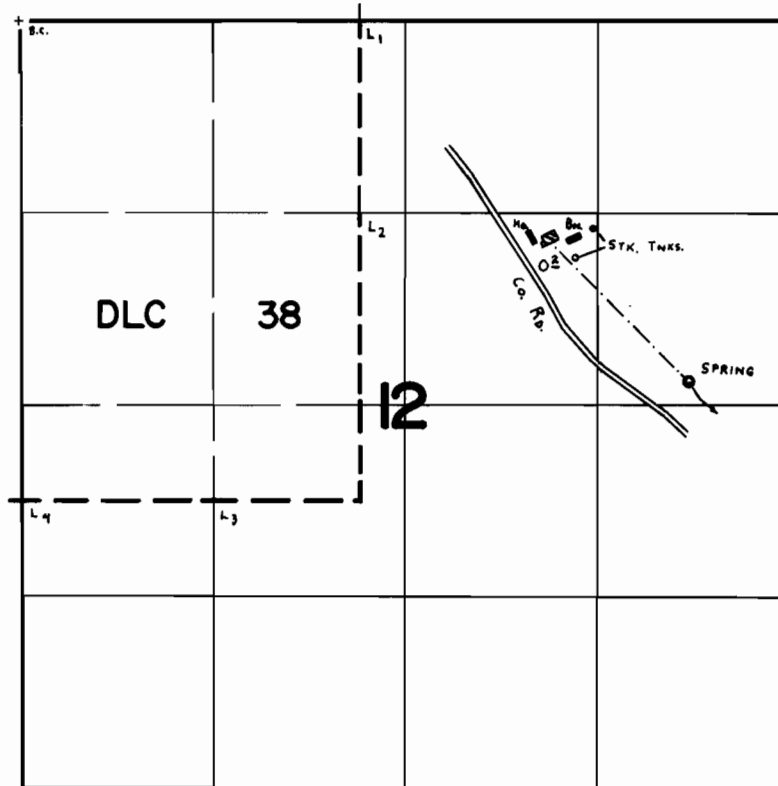

SPRING LOC: 2470' S. & 680' W. fr. N.E. Cor. Sec. 12.

FINAL PROOF SURVEY
UNDER

Application No. 57258 Permit No. 43081
IN NAME OF

MARY E. COLLIER

Surveyed AUG. 3 1978, by C. L. HUGHES