


T4S. RIE. WM.

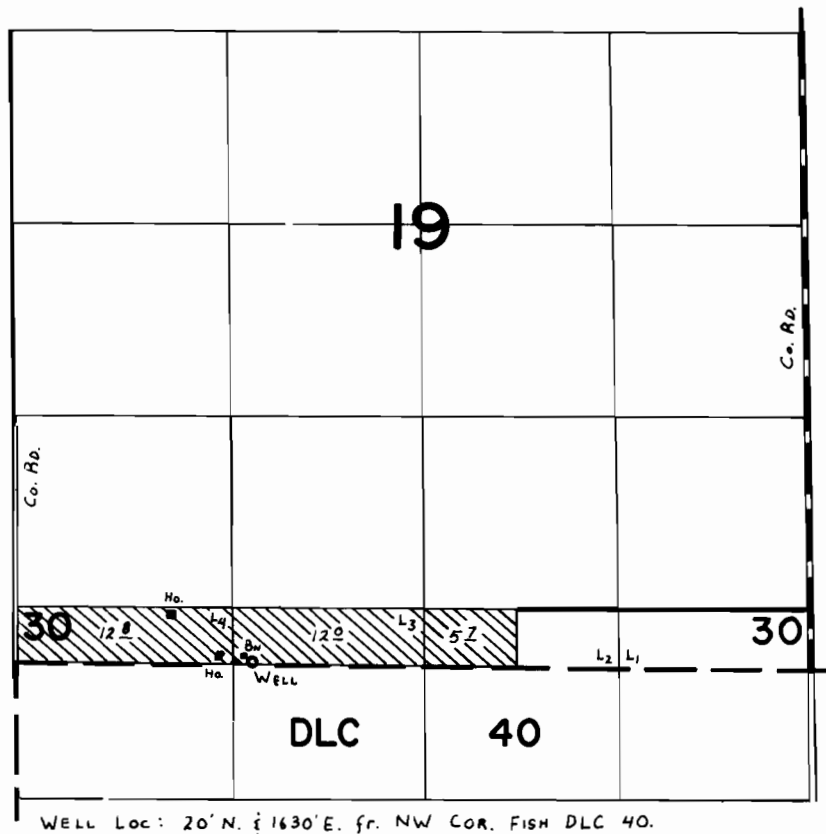

FINAL PROOF SURVEY
UNDER

Application No. G-6840 Permit No. G-6330
IN NAME OF _____

CLARENCE B. HANFORD

Surveyed JULY 31 1978, by C. L. HUGHES