


T3S. R1E. WM.

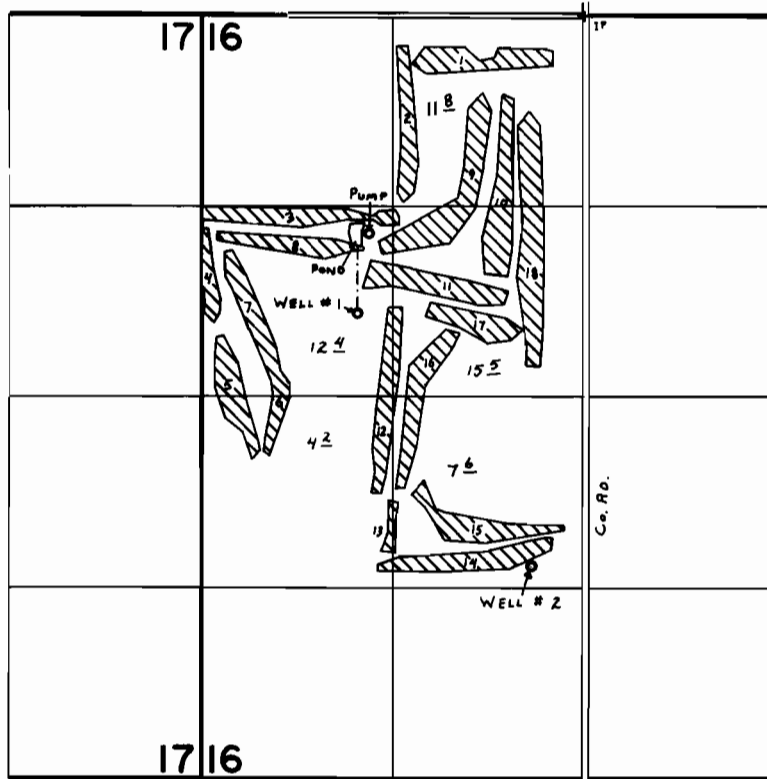

WELLS Loc: #1 - 2050' S. & 1560' W. } ALL FROM N. 1/4 COR. SEC. 16.
 #2 - 3780' S. & 960' W. }
 PUMP Loc: 1500' S. & 1480' W. }

FINAL PROOF SURVEY UNDER

Application No. G-6909 Permit No. G-6433
 IN NAME OF

SANDELIE GOLF CLUB, INC.

Surveyed OCT. 4 1978, by C. L. HUGHES