


T3S. R2E. WM.

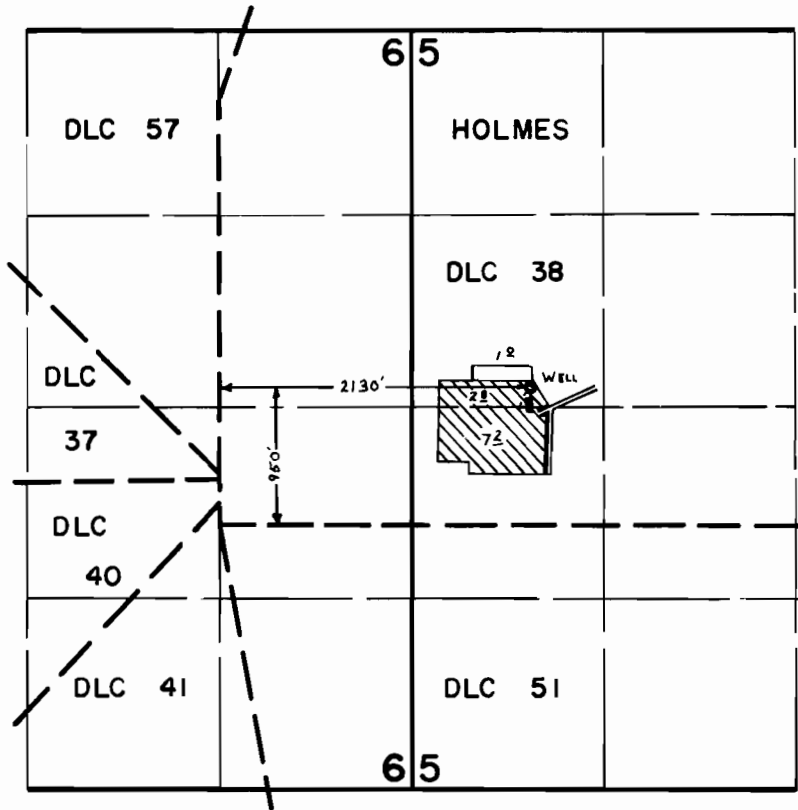

FINAL PROOF SURVEY UNDER

Application No. G-7470 Permit No. G-6954
IN NAME OF

ARCHDIOCESE OF PORTLAND IN OREGON

Surveyed OCT. 17, 1978, by C. L. HUGHES