


5058

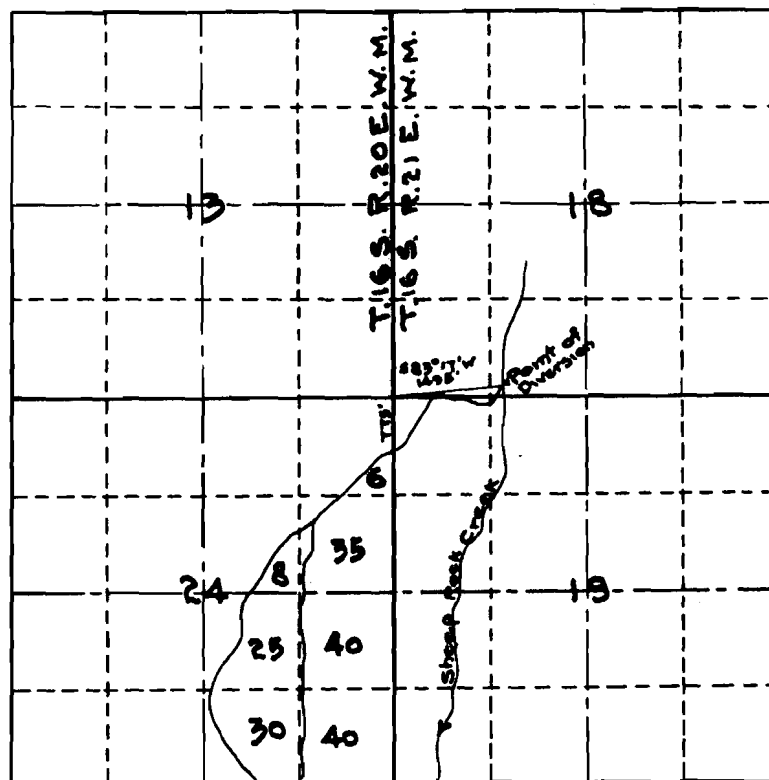

H. Keeling
Surveyor.

RECEIVED

MAY 11 1973

SALEM OREGON

4906
2916

2916