


T4S. R1E. WM.

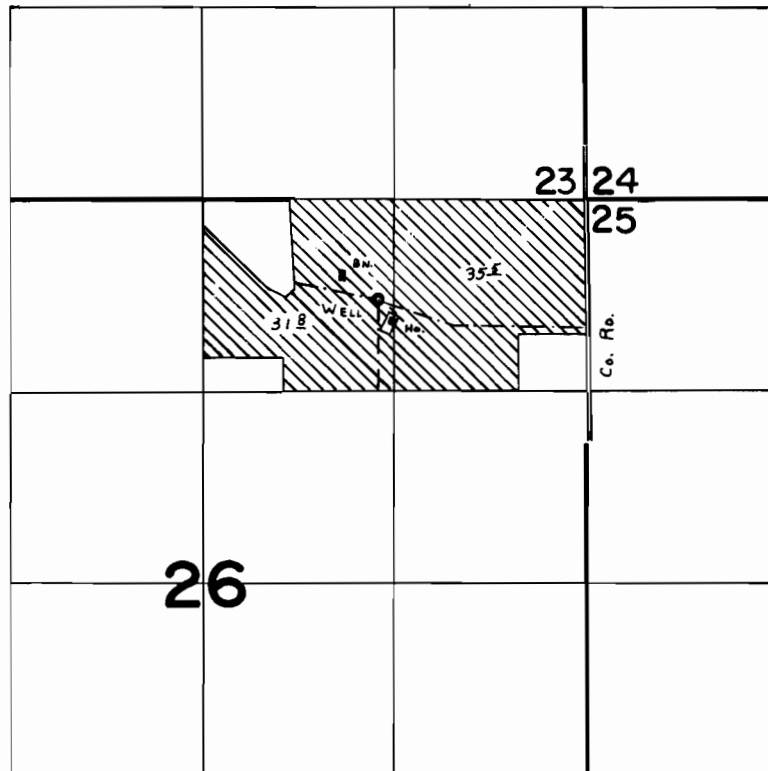

WELL LOC: 690'S. & 1425' W. fr. N.E. COR. SEC. 26.

FINAL PROOF SURVEY
UNDER

Application No. G-8103 Permit No. G-7488
IN NAME OF

CHARLES R. MORGAN

Surveyed AUG. 1 1978, by C. L. HUGHES