


T4S. R1E. WM.

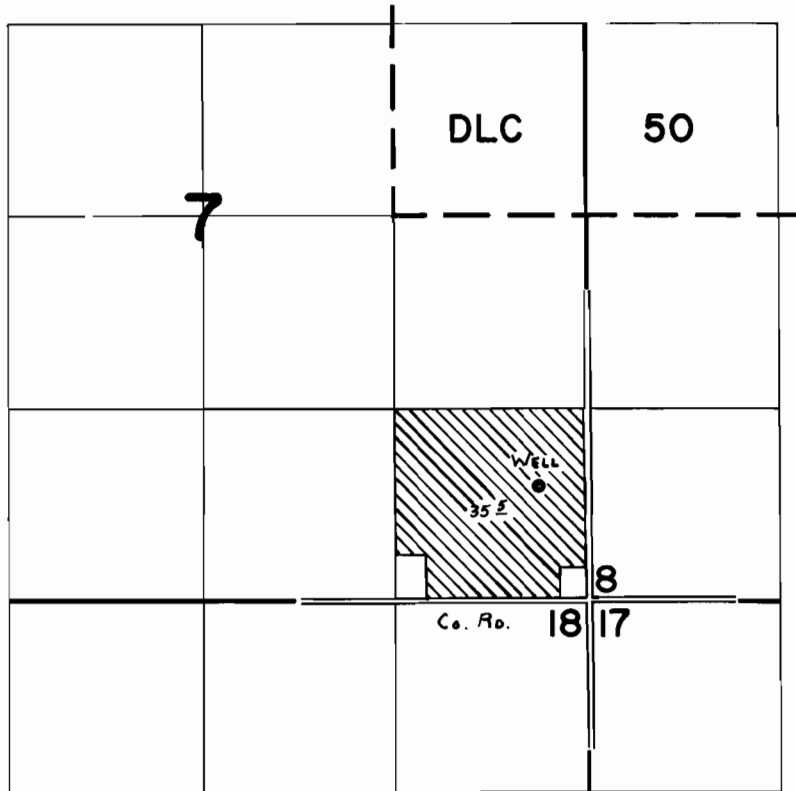

WELL Loc : 780' N. & 330' W. fr. S.E. Cor. Sec 7.

FINAL PROOF SURVEY UNDER

Application No. G-8482 Permit No. G-7935
IN NAME OF

MONTECUCCO FARMS

Surveyed JULY 31, 1978, by C. L. HUGHES