


T. 26 S., R. 11 W., W.M.

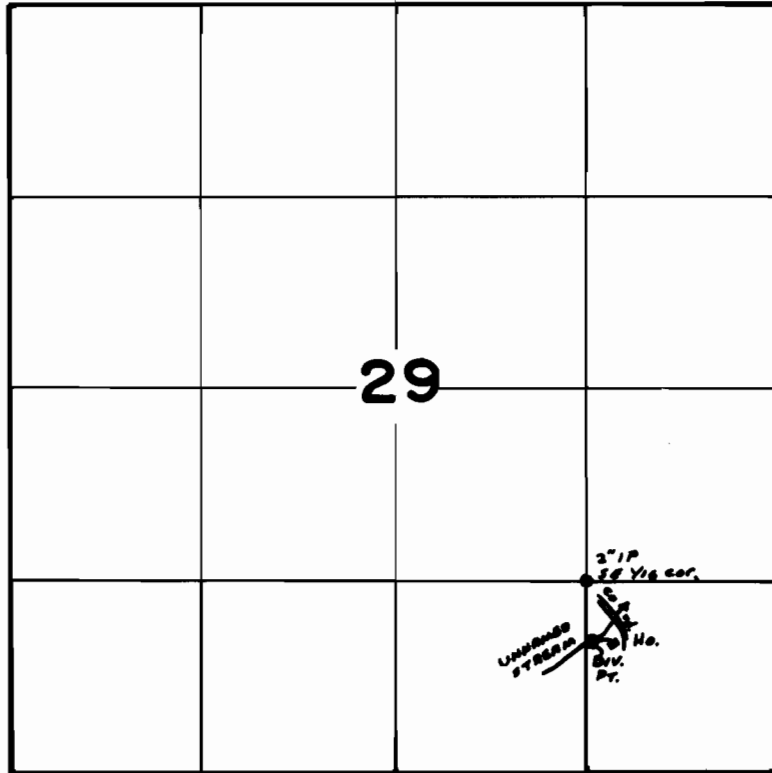

DIV. PT. : 400'S & 50'E from SE 1/16 cor.

SCALE: 4" = 1 mile

FINAL PROOF SURVEY UNDER

Application No. 49139... Permit No. 36846.
IN NAME OF

.....*Marvin Crawford*.....

Surveyed O.C.T. 10, 1979, by S. DONALDSON