


T. 27 S., R. 13 W., W.M.

SEC. 1

SE 1/4 NW 1/4

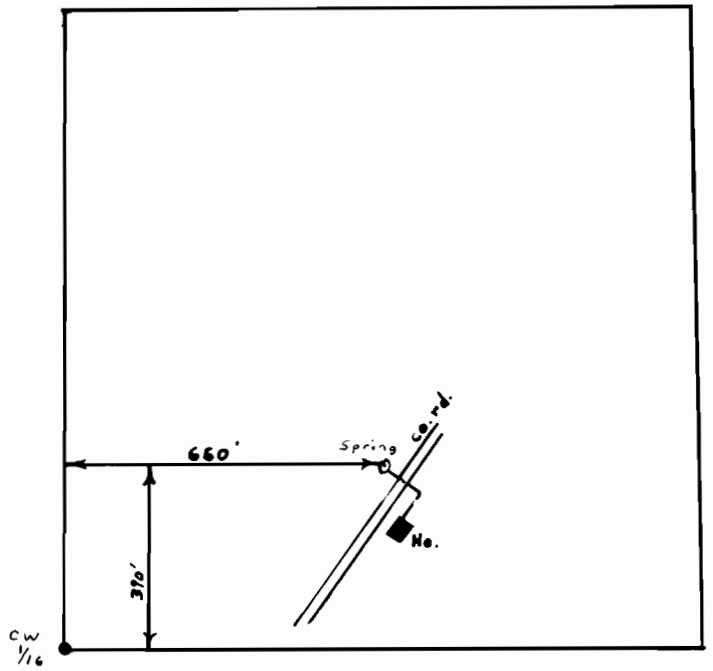

SCALE : 1" = 400'

FINAL PROOF SURVEY
UNDER

Application No. 4914.5... Permit No. 36850..
IN NAME OF

.....*Marvin Nicholson*.....

Surveyed SEPT. 10, 1979, by S. DONALDSON