


T.18&19S. R.24&25E., W.M.

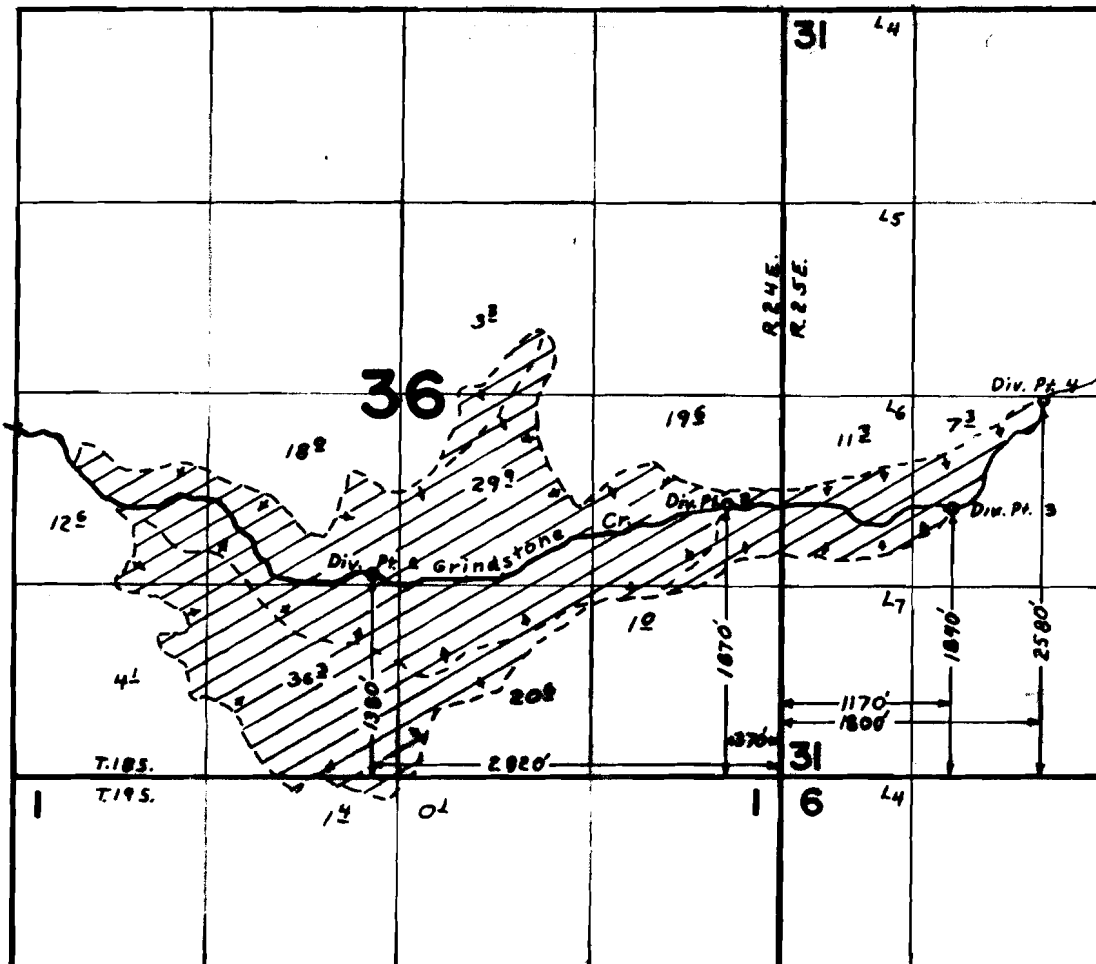

**FINAL PROOF SURVEY
UNDER**

Application No. 39887..... Permit No. 29764.
IN NAME OF

Sheep Mountain Cattle Company

Surveyed JULY 25 1978, by J.S.DONALDSON