


T. 36 S., R. 4 W., W. M.

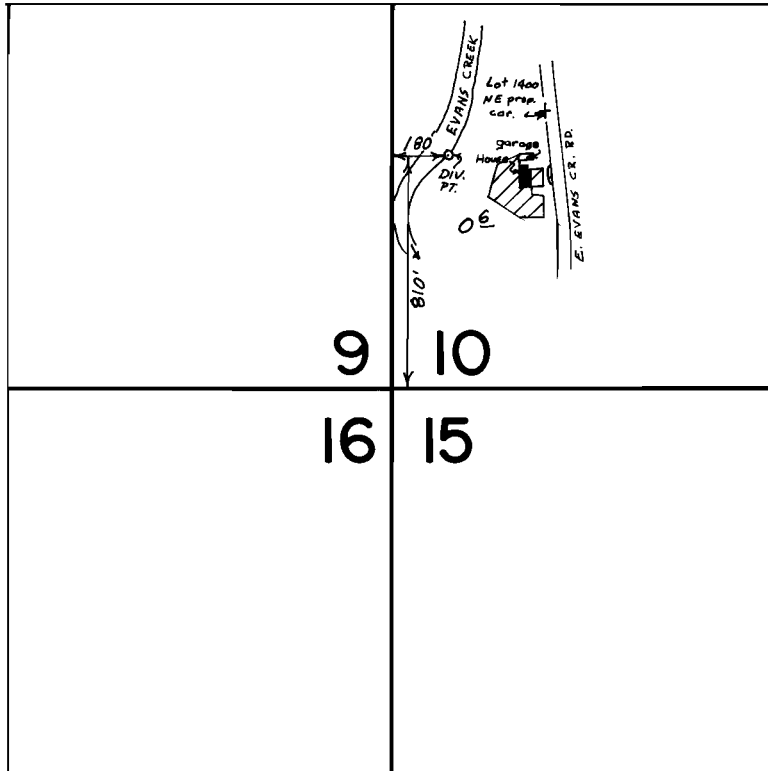

scale: 1" = 660'

FINAL PROOF SURVEY
UNDER

Application No. 51855... Permit No. 39041...
IN NAME OF

MAYBEL B. ORTEGA

Surveyed Apr. 11... 1978, by B. R. SUND