


T. 35S., R. 6W., W.M.

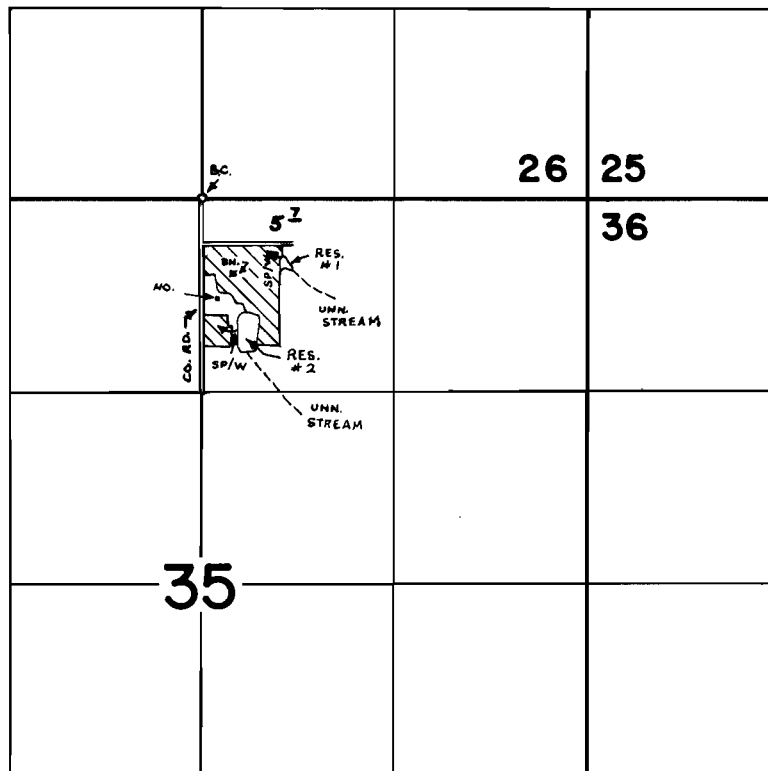

DAM #1 LOC.: 400' S. & 540' E., #2 - 800' S. & 250' E., BOTH
FROM N. 1/4 COR. SEC. 35.

FINAL PROOF SURVEY
UNDER

R-48041 R-5828
Application No. 48042 Permit No. 36026
IN NAME OF
RAY M. & MARY ANNE RODOLF

Surveyed NOV. 1 1977 by B. SUND