


T.36 S., R.6 W., W.M.

SEC. 14

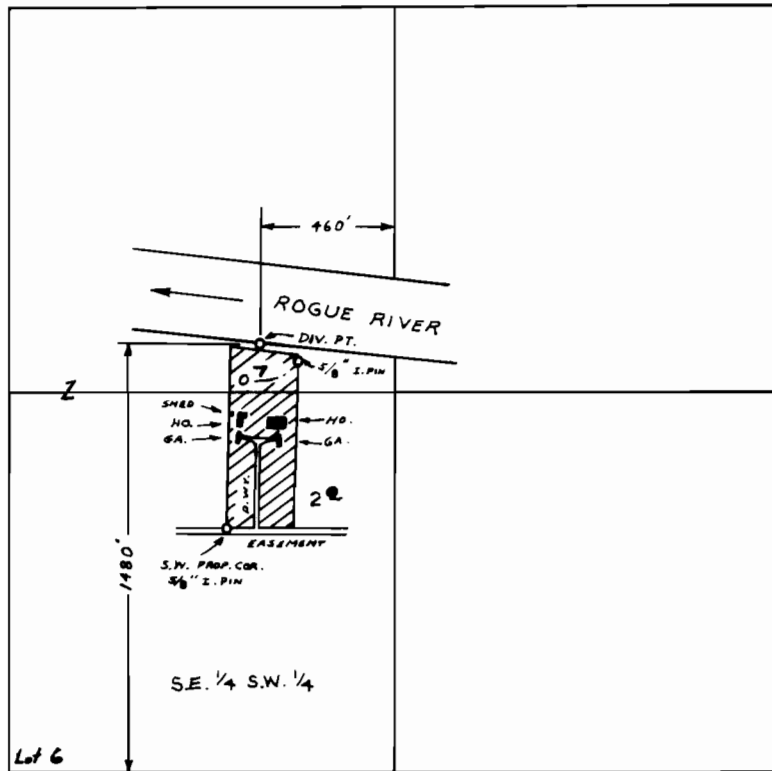

SCALE: 1" = 660 FT.

FINAL PROOF SURVEY UNDER

Application No. 54714 Permit No. 41046
IN NAME OF

DAREL L. KRUTSINGER

Surveyed NOV. 1 1978, by B. SUND