


R 6545
50601

T40S. R26E. WM.

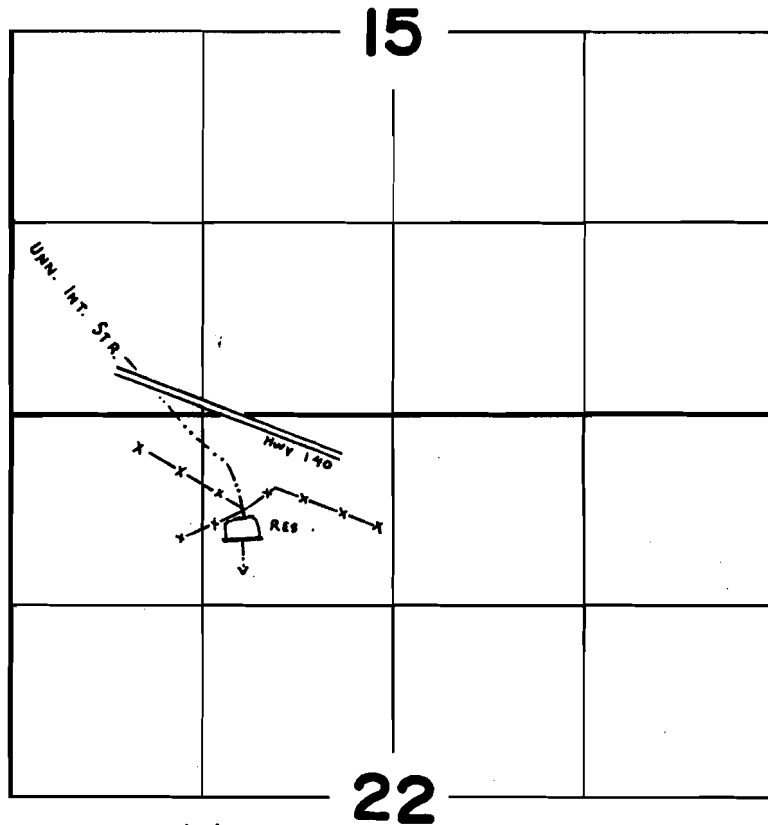

DAM Loc: 850'S $\frac{1}{2}$ 1580'E fr. NW Cor Sec 22.

FINAL PROOF SURVEY
UNDER

Application No. R-54787 Permit No. R-6545
IN NAME OF

U.S. DEPT. of INT. BLM.

Surveyed JUNE 28 1978, by C. L. HUGHES