


G 5737
50604

T. 39S. R. 20E.W.M.

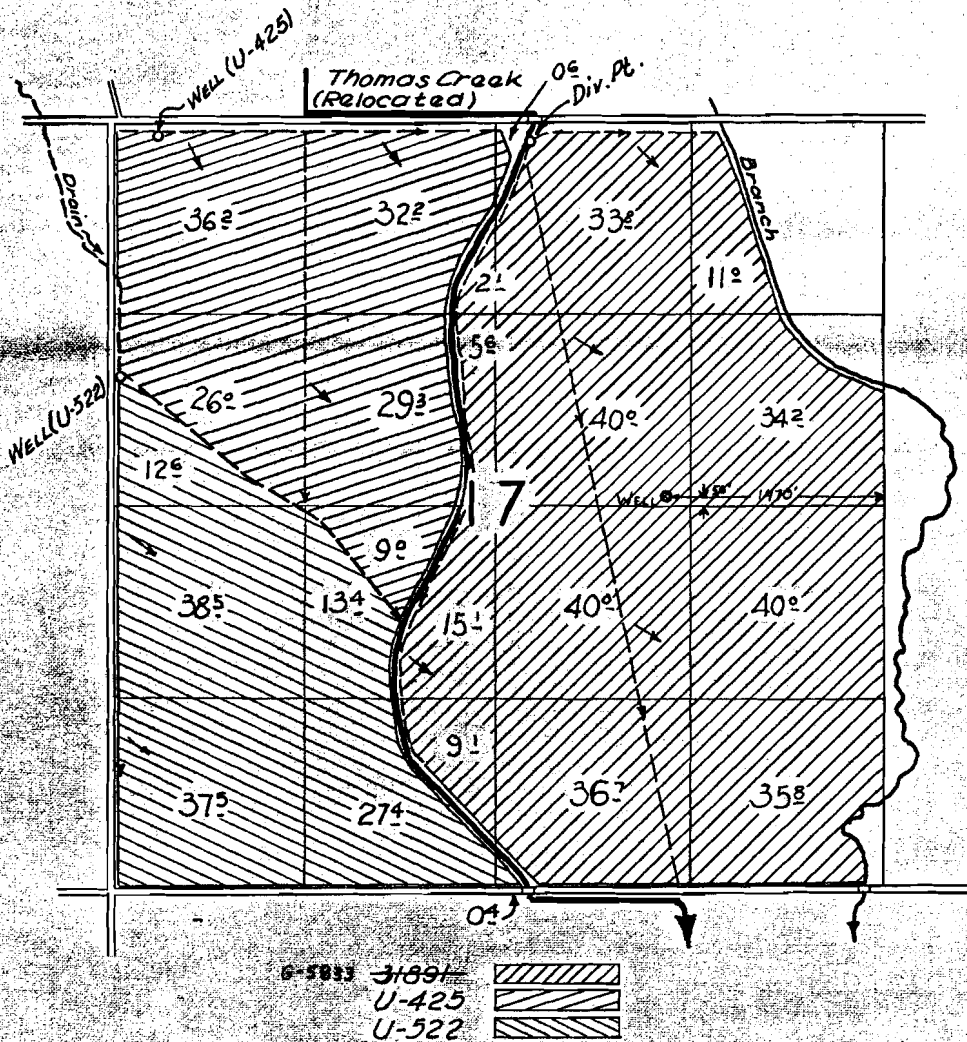

FINAL PROOF SURVEY
UNDER

G-5833	31891	G-5737	25614
	U-425		U-393
Application No. U-522	Permit No. U-474		

IN NAME OF
HARRY HUNTER ESTATE, INC. &
FAVELL-UTLEY REALTY CO.

Surveyed 13 May 1959, by *L. Jackson*