T.17S. R.3W., W.M.

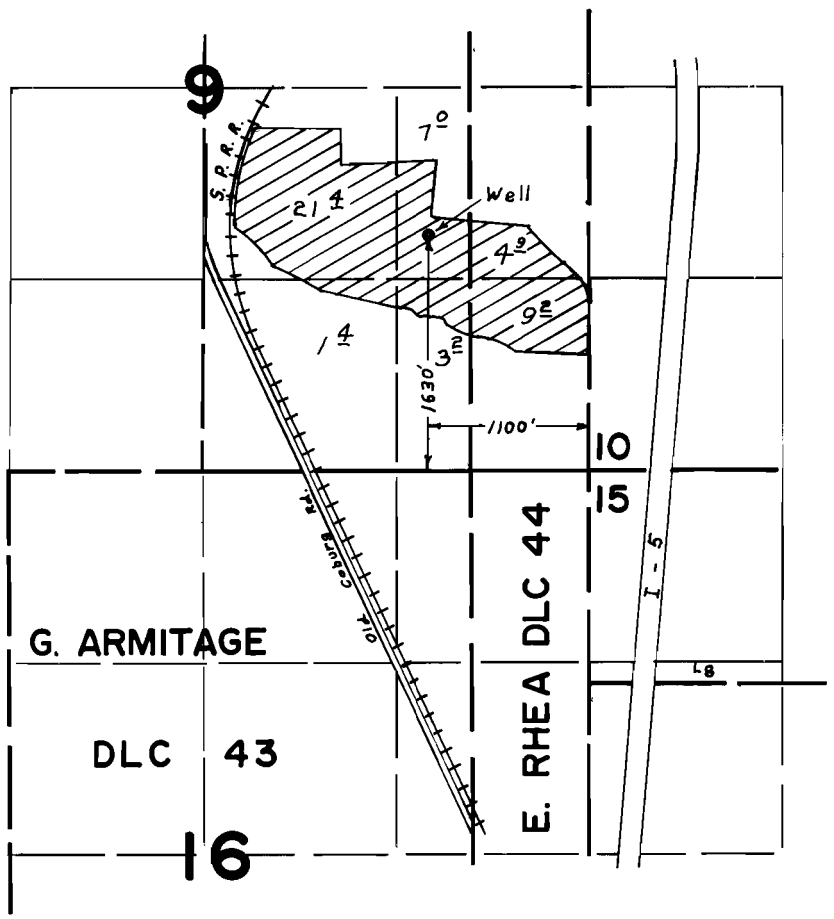

FINAL PROOF SURVEY
UNDER

Application No. G-7995 Permit No. G-7417
IN NAME OF

HOILAND BROS.

Surveyed MAY 15 1978, by J.S. DONALDSON

DBQ-2JJ-162