


T.18S. R.2 & 3 W., W.M.

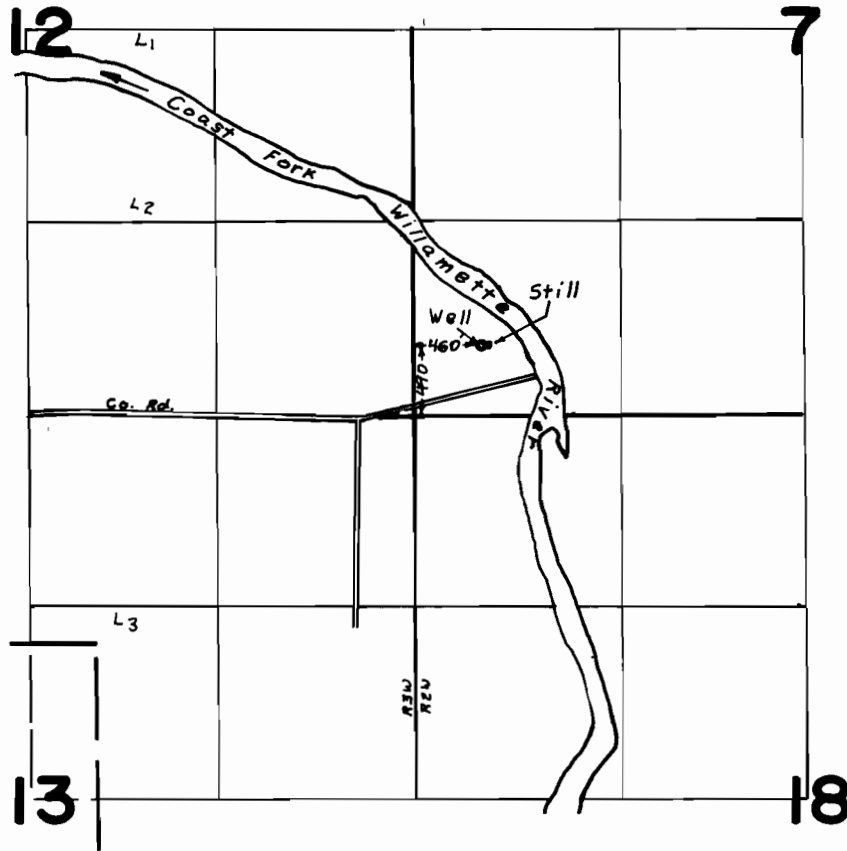

FINAL PROOF SURVEY UNDER

Application No. G-8003. Permit No. G-7442.
IN NAME OF

..... W. G. or INA M. SAUNDERS

Surveyed SEP. 12. 1978, by J. S. DONALDSON