


T.8S.,R.1W.,W.M.

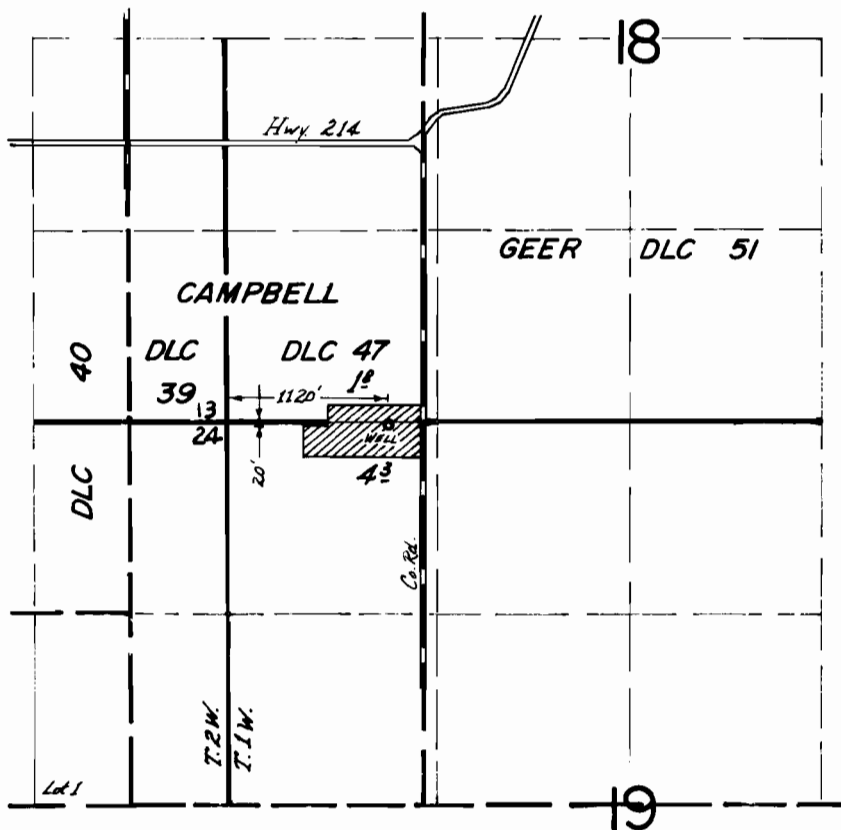

FINAL PROOF SURVEY
UNDER

Application No. G-7109 Permit No. G-6573
IN NAME OF

MICHAEL STEWART

Surveyed Oct. 19 1978 by *[Signature]*