


T.4S. R.2W., W.M.

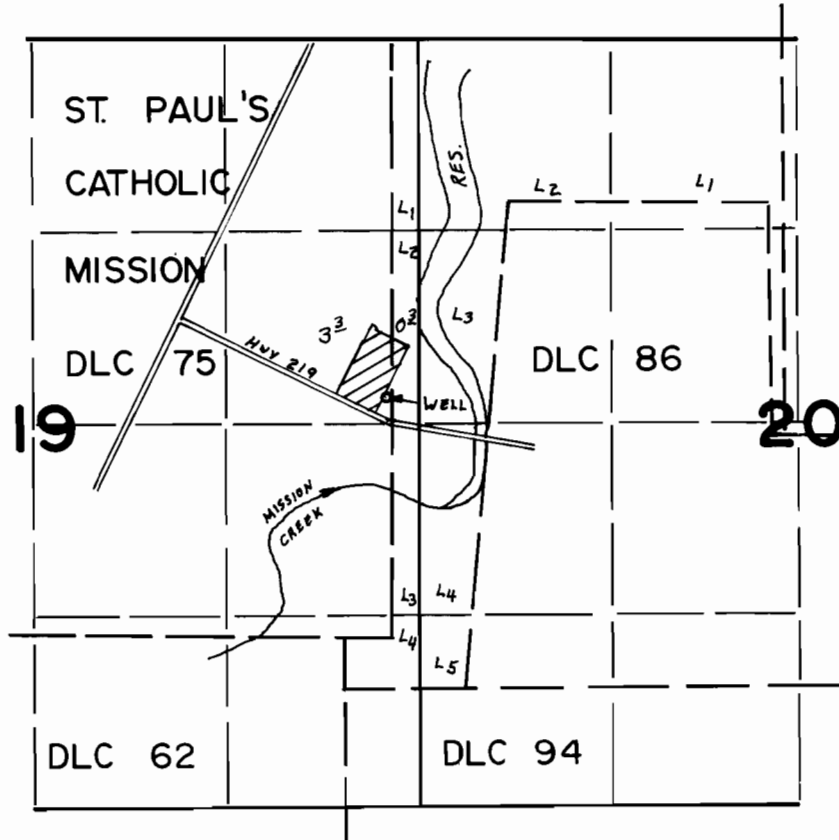

WELL LOC. 2000' N. & 290' E. FROM N.W. COR. DLC 94

FINAL PROOF SURVEY UNDER

Application No. G-7615 Permit No. G-7061
IN NAME OF

ST. PAUL CEMETERY ASSOCIATION.

Surveyed SEP. 26. 1978., by S.P. APPLGATE.