


T. 6S. R. 1E. W. 1M.

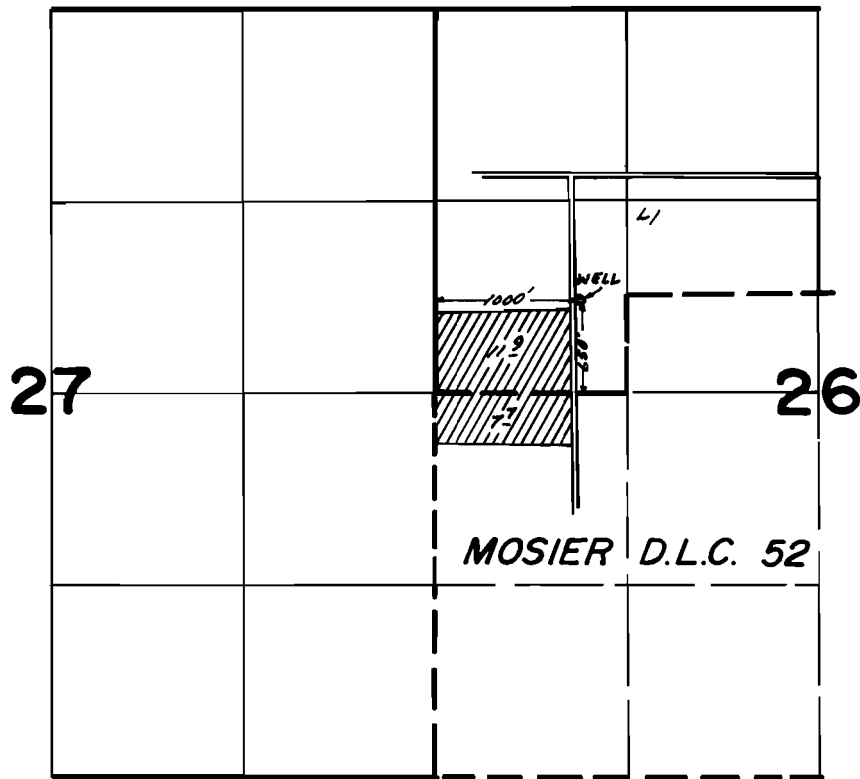

FINAL PROOF SURVEY UNDER

Application No. ~~G-7966~~ Permit No. ~~G-7540~~
IN NAME OF

JOSEPH or JOSEPHINE BIELENBERG

Surveyed Oct. 3, 1978, by J.S. Donaldson.