


T. 6S.R.2W. W.M.

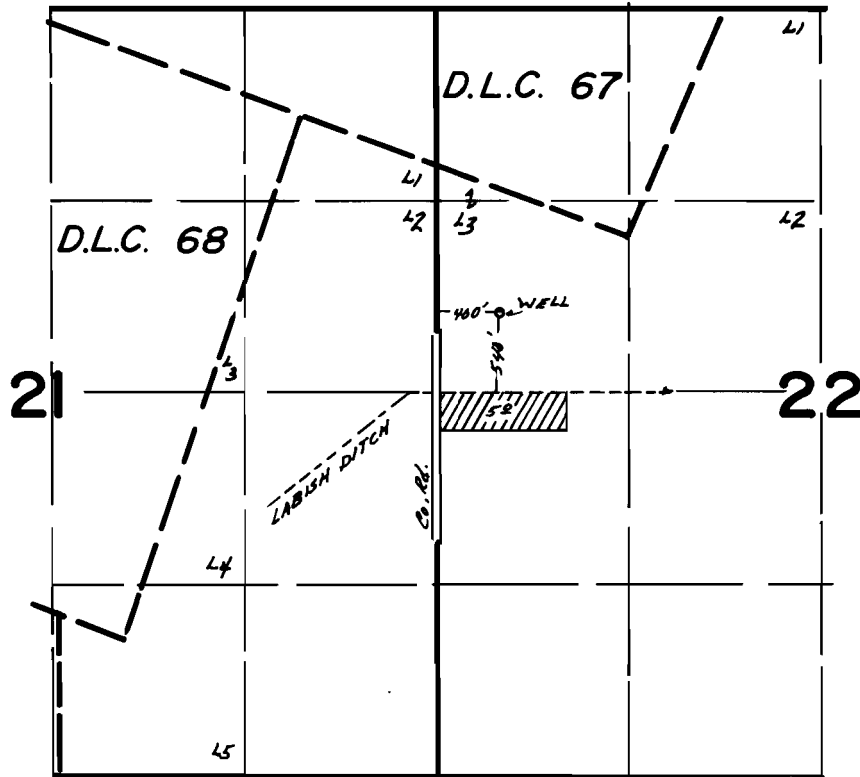

FINAL PROOF SURVEY UNDER

Application No. G-8718 Permit No. G-8025
IN NAME OF

GREGORY H. BENNETT

Surveyed Oct. 6, 1978, by J.S. Donaldson