


T6S. R7W. WM.

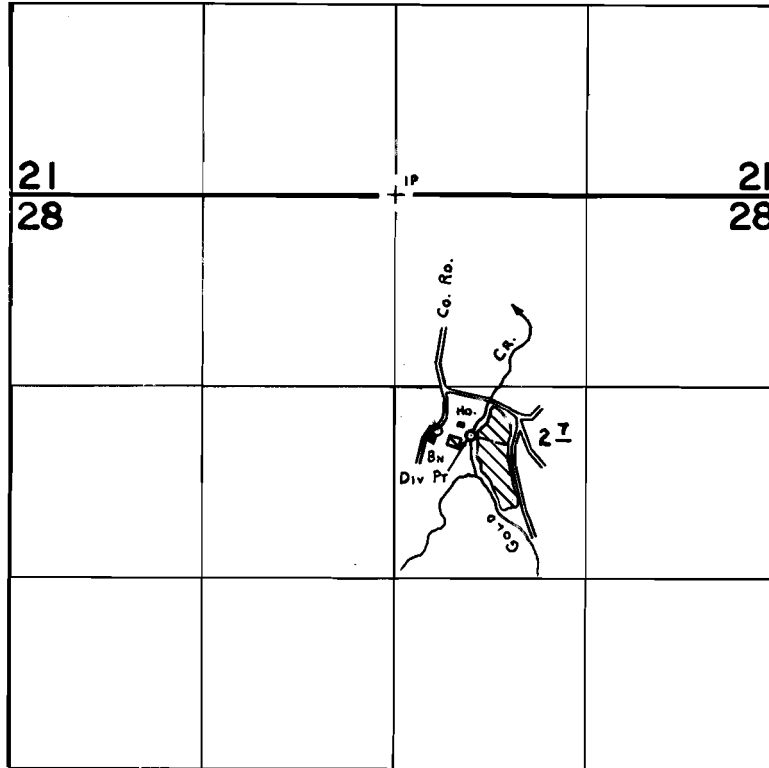

Div. Pt. Loc: 1650' S | 520' E from N¹/₄ corner Section 28

FINAL PROOF SURVEY
UNDER

Application No. 53397 Permit No. 39865
IN NAME OF

JACK SMITH

Surveyed SEPT. 8 1978 by C. L. HUGHES