


# T6S. R7W. WM.

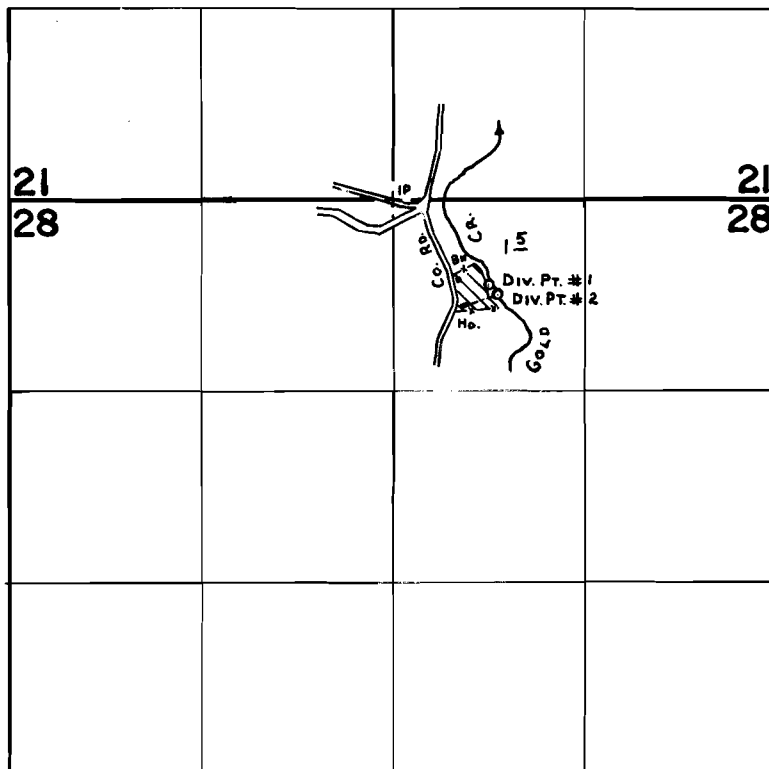

Div. Pts. Loc: #1 - 580'S & 660'E } BOTH fr. N 1/4 COR SEC 28.  
#2 - 650'S & 710'E }

## FINAL PROOF SURVEY UNDER

Application No. 53398 Permit No. 39866  
IN NAME OF

GLENN H. BRENEMAN

Surveyed SEPT. 8, 1978, by C. L. HUGHES