


T6S. R7W. WM.

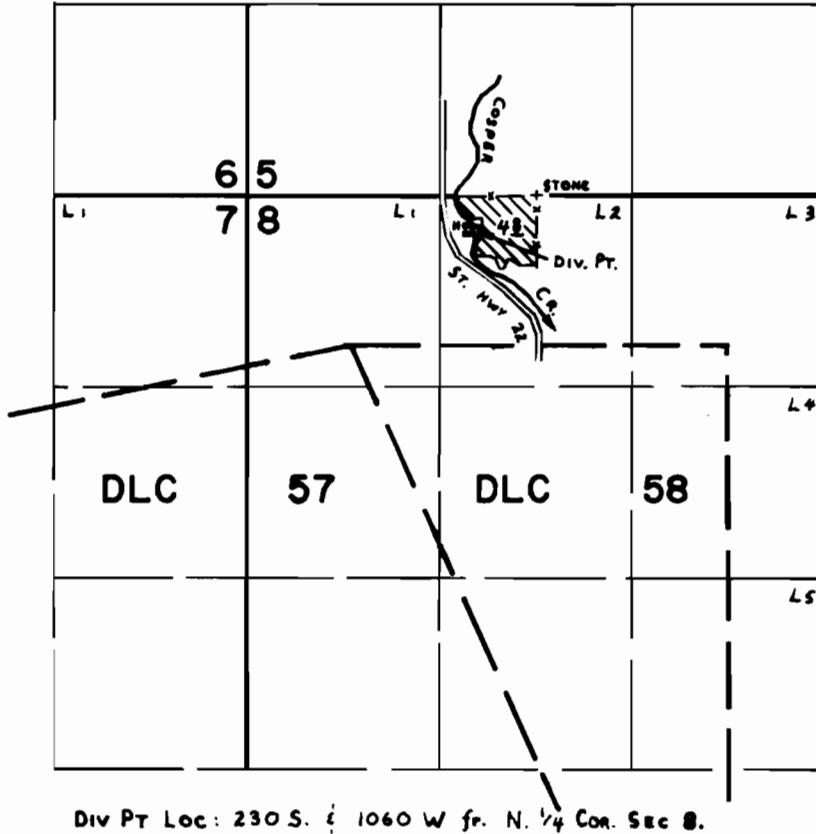

FINAL PROOF SURVEY UNDER

Application No. 54989 Permit No. 41267
IN NAME OF

CLIFFORD H. ELLIS

Surveyed SEPT. 6 1978, by C. L. HUGHES