


T. 4 S., R. 10 W., W.M.

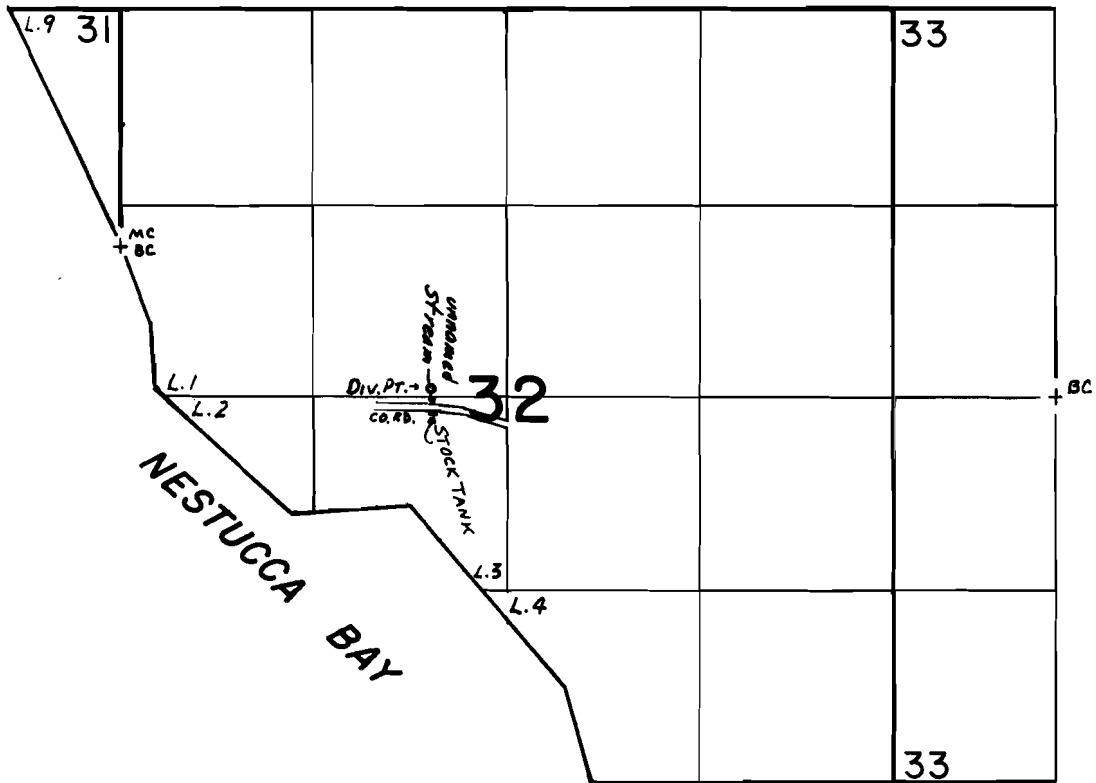

Div. Pt. Loc. 50' N. & 450' W. From Center Sec. 32

FINAL PROOF SURVEY
UNDER

Application No. 43631 Permit No. 33133
IN NAME OF

DENNIS M. WALDRON

Surveyed MAY 23, 1978, by J.S. DONALDSON