


T. 3S., R. 9W. W.M.

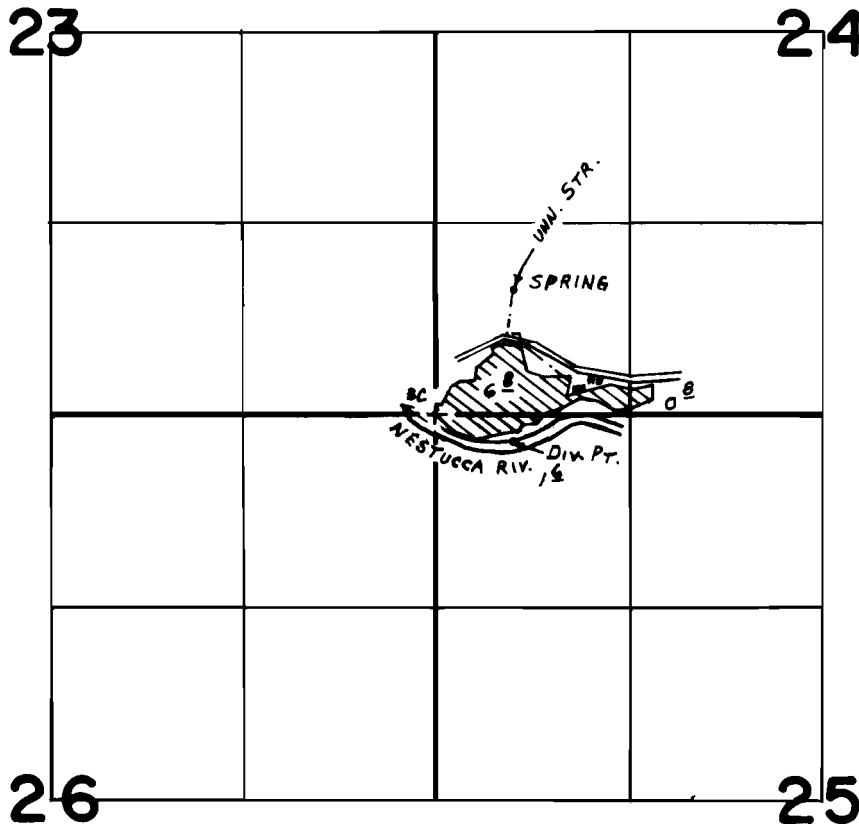

Div. Pt. Loc: Spring, 850' N. & 540' E. From SW Cor. Sec. 24
River, 200' S. & 530' E. From NW Cor. Sec. 25

FINAL PROOF SURVEY UNDER

Application No. 55160.... Permit No. 41346....
IN NAME OF

.....THOMAS...BLANCHARD.....

Surveyed Apr. 5..... 1978, by J.S. DONALDSON