


T. 4 N. R. 27 & 28 E. W. M.

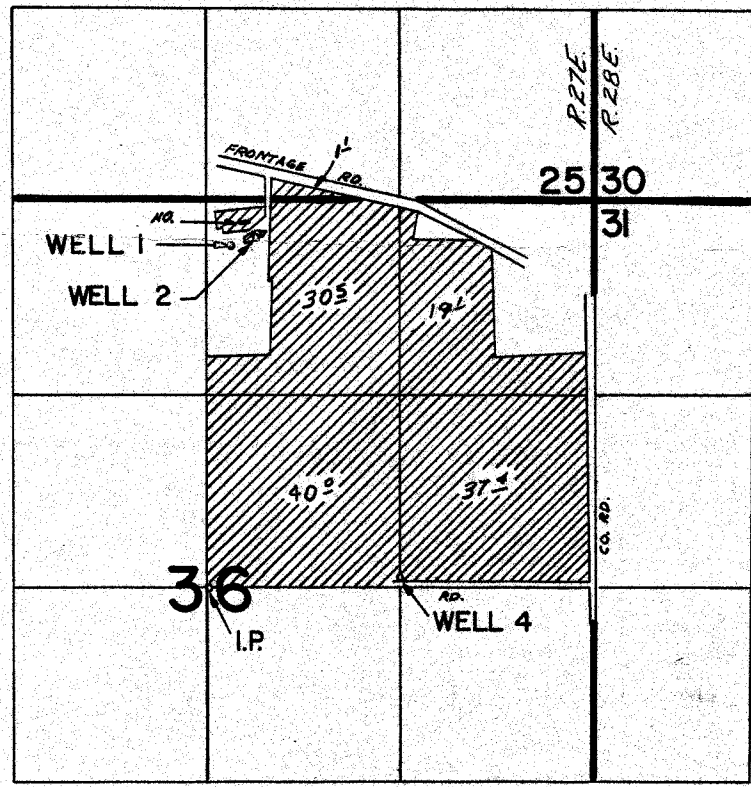

WELLS LOC. : WELL 1 2340' N & 160' E, WELL 2
 2400' N & 330' E WELL 4 70' N & 1310' E ALL
 FROM CENTER SEC. 36

FINAL PROOF SURVEY UNDER

Application No. G-3945 Permit No. G-3702
 IN NAME OF

Robert Hampton

Surveyed 8-25 1971, by L. GOULD
 8-4 78 R. BARWIN