


T. 2S. R. 43E. W.M.

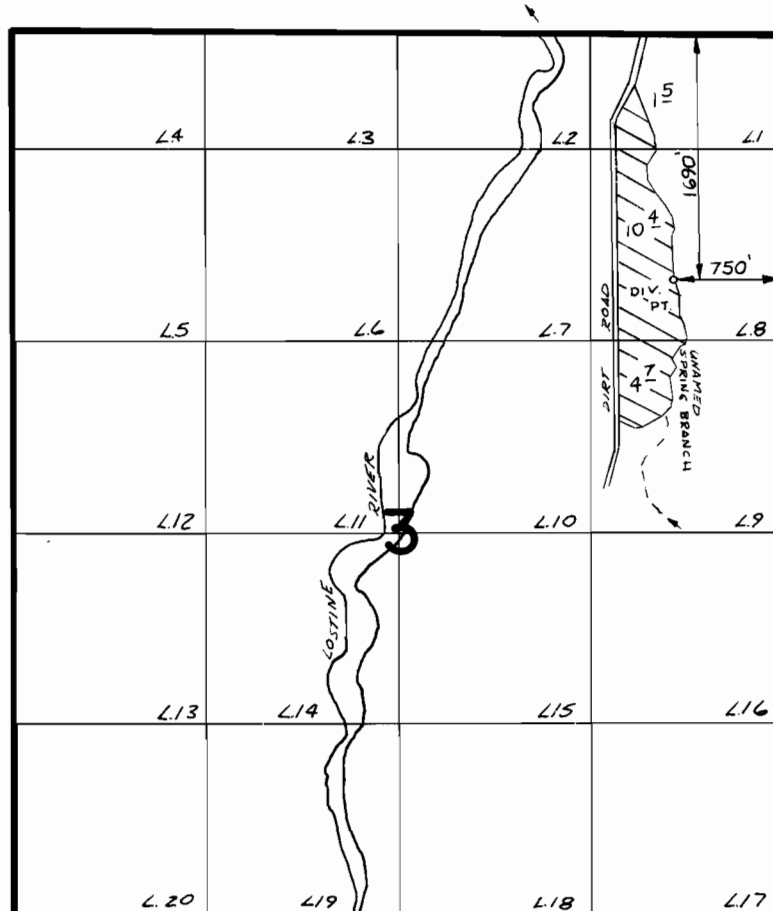

FINAL PROOF SURVEY
UNDER

Application No. **54999** Permit No. **41212**
IN NAME OF

JOE W. WAIBEL

Surveyed **8-30** 1978, by **R. BARWIN**