


Application No. R-53606  
Permit No. R 6401

T.I.S. R.I.W.WM

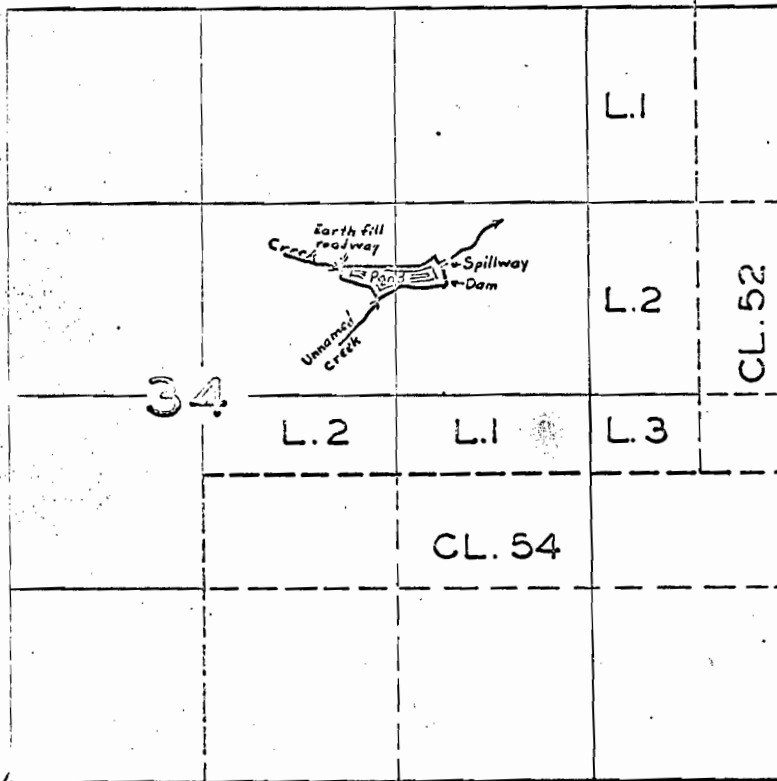

**FINAL PROOF SURVEY**

UNDER

Application No. 23832 Permit No. 18829

IN NAME OF

R. E. ELLSON

Surveyed Apr. 15 1953, by H. L. Coffman