


T. 2S. R. 2W. W.M.

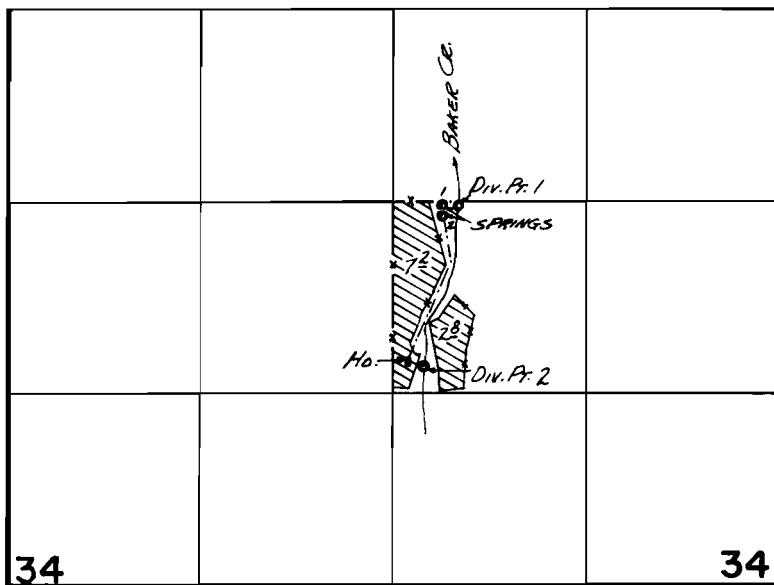

Div. Pts. from Creek - #1 - 20'S & 450'E
#2 - 1140'S & 220'E } ALL FROM CENTER 1/4
SPRING LOC. 100'S & 320'E } COR. SEC. 34

FINAL PROOF SURVEY
UNDER

Application No. **52968** Permit No. **39986**
IN NAME OF

WILLIAM J. MCGOWAN

Surveyed July 25, 1978, by R.G. Mucken