


T. 9S. R. 39E. W.M.

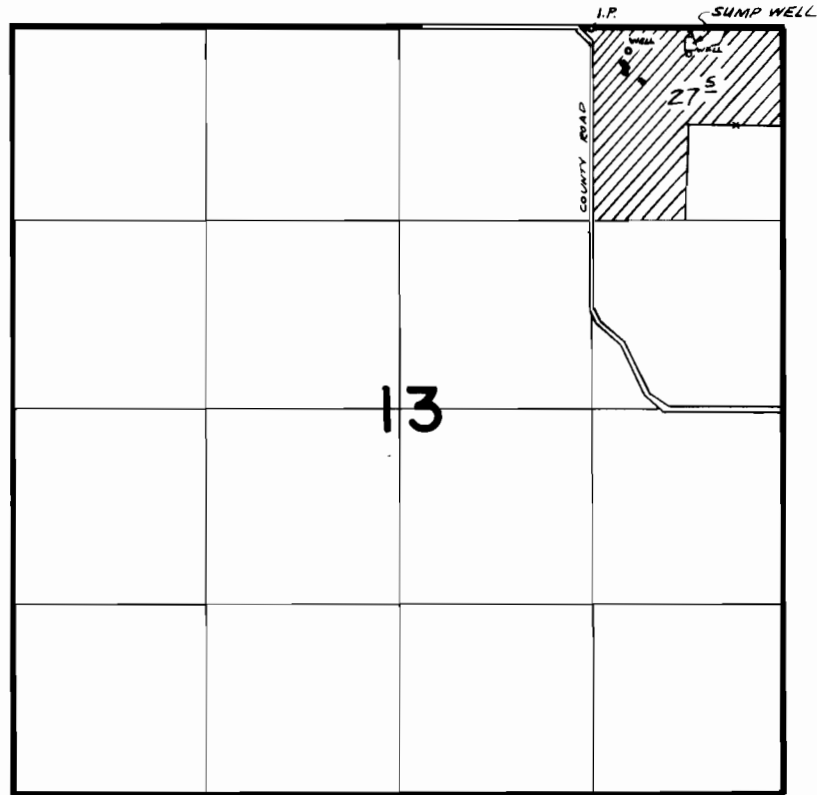

WELL LOC. 190'S & 650'W FROM NE COR SEC 13

**FINAL PROOF SURVEY**  
UNDER

Application No. G-5822... Permit No. G-5573...  
IN NAME OF

.....**MARCUS SACKOS**.....

Surveyed ..6-2..... 1978., by *R. BARWIN*.....