


T. 10S. R. 40E. W. M.

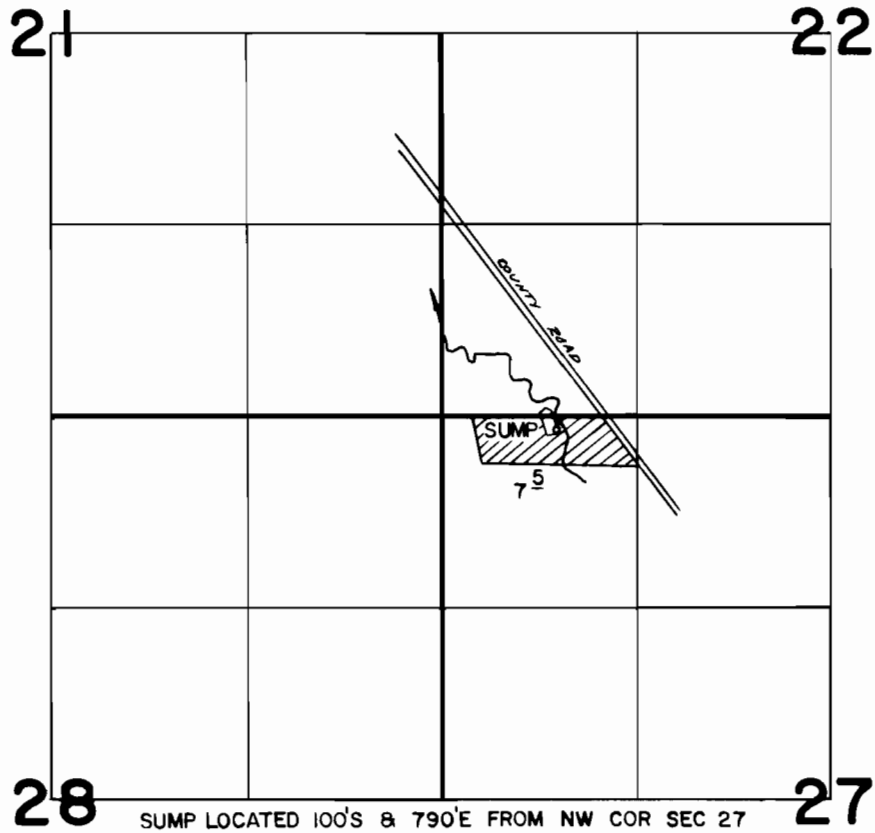

FINAL PROOF SURVEY
UNDER

Application No. G-6103 Permit No. G-5781
IN NAME OF

JIM HINDMAN

Surveyed 11-2 1978, by R. BARWIN