


T. 14S. R. 5W. W.M.

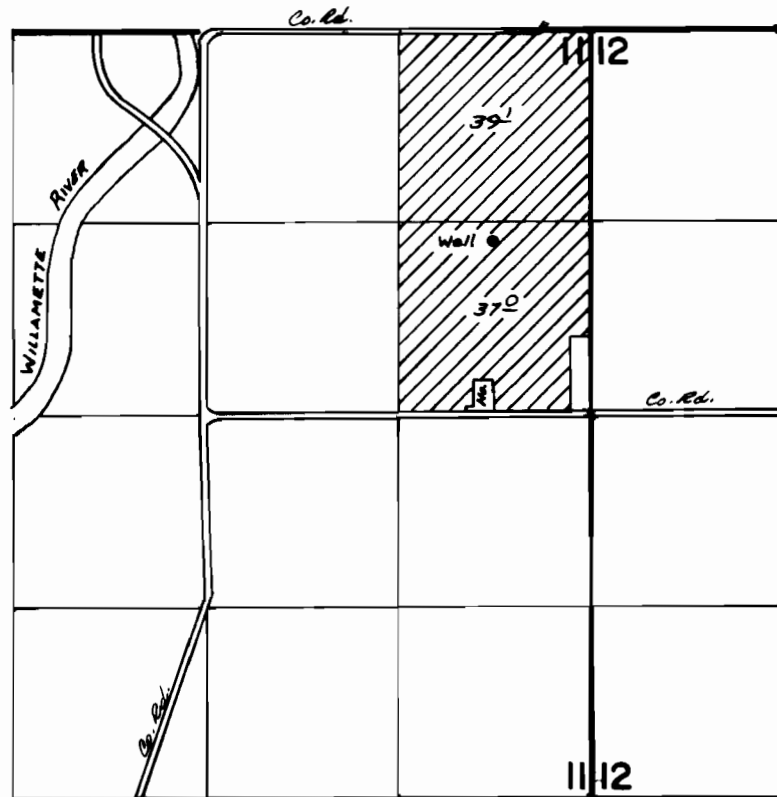

Well Loc. 1440' S & 690' W From NE Cor. Sec. 11

FINAL PROOF SURVEY
UNDER

Application No. G-6239. Permit No. G-5884..
IN NAME OF

.....*Crocker Farms*.....

Surveyed Sept. 25, 1978., by J.S. Donaldson....