


# T4S. R1E. WM.

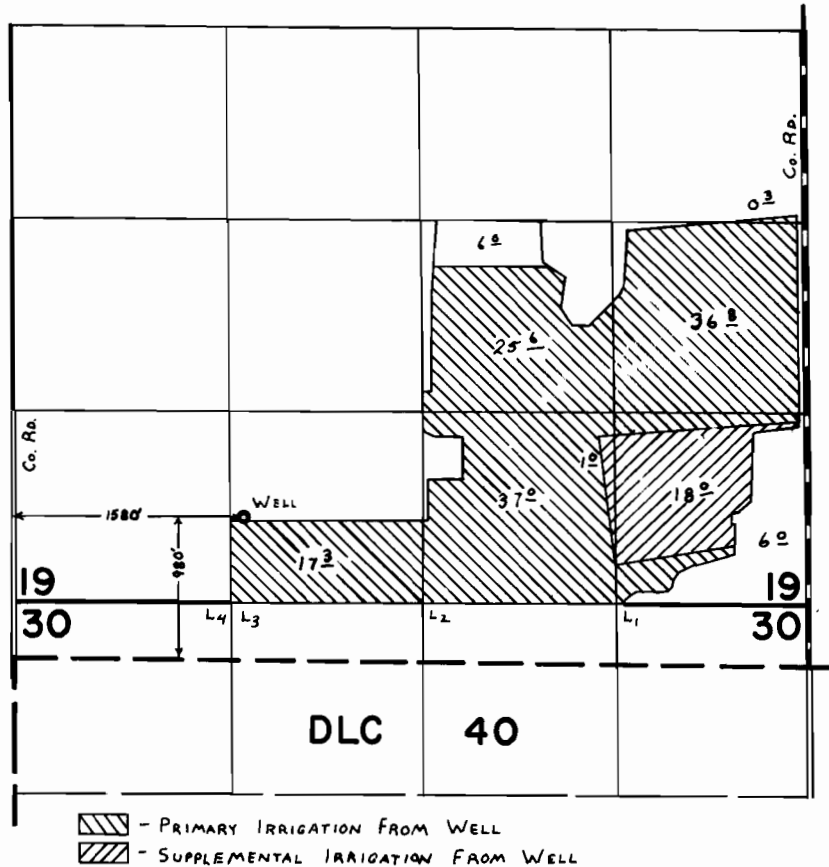

## FINAL PROOF SURVEY UNDER

Application No. G-7161 Permit No. G-6086  
IN NAME OF

ELLIS J. HESTER

Surveyed JULY 31 1978, by C. L. HUGHES